


RECEIVED

SEP 22 1997

WATER RESOURCES DEPT.
SALEM, OREGON

T13S R31E

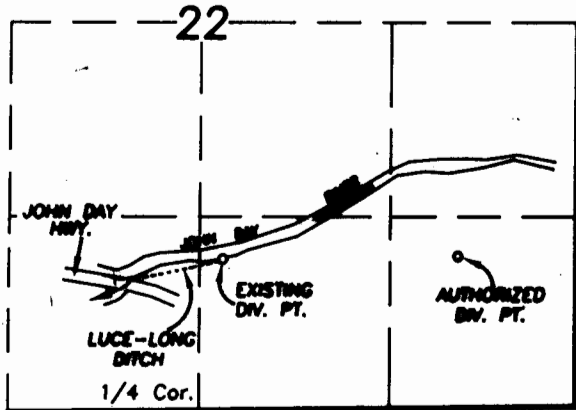

AUTHORIZED DIV. PT.
SCALED FROM THE
AJUDICATION MAP.
LATER PERMITTED
RIGHTS SHOW OTHER
DIVERSION POINTS.

AUTHORIZED DIV. POINT IS 1100' N. AND 800' W. OF THE SE CORNER OF SEC. 22

EXISTING DIV. POINT IS 1040' N. AND 100' E. OF THE S. 1/4 COR. OF SEC. 22



SCALE 1" = 1320'

FINAL PROOF SURVEY
UNDER
T-6607

IN THE NAME OF
GRANT COUNTY ROAD DEPARTMENT
SURVEYED SEPT. 12, 1997 BY R.D. BAGETT

BAGETT-GRIFFITH & BLACKMAN
P.O. BOX 476
JOHN DAY, OR. 97845

PLACE OF USE WITHIN ROAD DEPT.
SERVICE AREA IN GRANT COUNTY.

NOTE: THE PREPARATION OF THIS MAP
WAS FOR THE PURPOSE OF IDENTIFYING
THE LOCATION OF THE PROPOSED WATER
RIGHT AND HAS NO INTENT TO PROVIDE
DIMENSIONS OR LOCATION OF PROPERTY
OWNERSHIP LINES.

