


T. 3 S., R. 3 S., W.M.


I certify that the information I have provided in this Final Proof is an accurate representation of the permitted water use and is true and correct to the best of my knowledge. This map is to be used for the purpose of identifying the location of water right only and is not intended to provide legal dimensions or locations of property ownership lines.

Matt Dunckel, CWRE

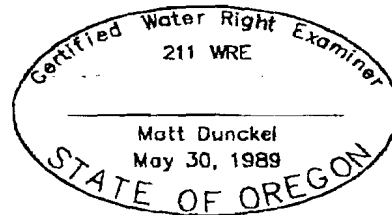

North

Place of Domestic Use Expanded.

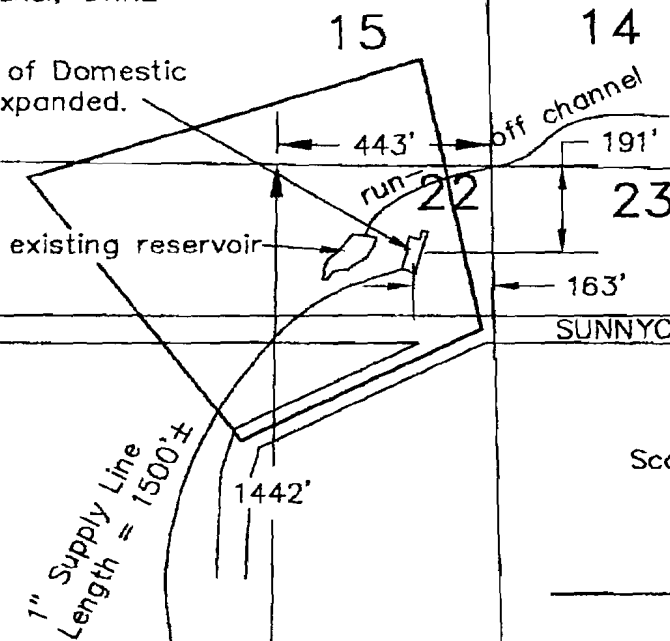

Scale: 1" = 400'

LEGEND:

- _____ = Property line
- _____ = Section line
- _____ = "40" line

EXISTING SPRING & POINT OF DIVERSION

FINAL PROOF SURVEY
UNDER

Application No. R-72447 Permit No. S-51668

IN NAME OF

RODNEY & STARR MANSON

Surveyed 1 DEC., 2003,

RECEIVED

DEC 29 2003

WATER RESOURCES DEPT
SALEM, OREGON

#1413