


T. 27 S., R. 14 W., W.M. Section 5

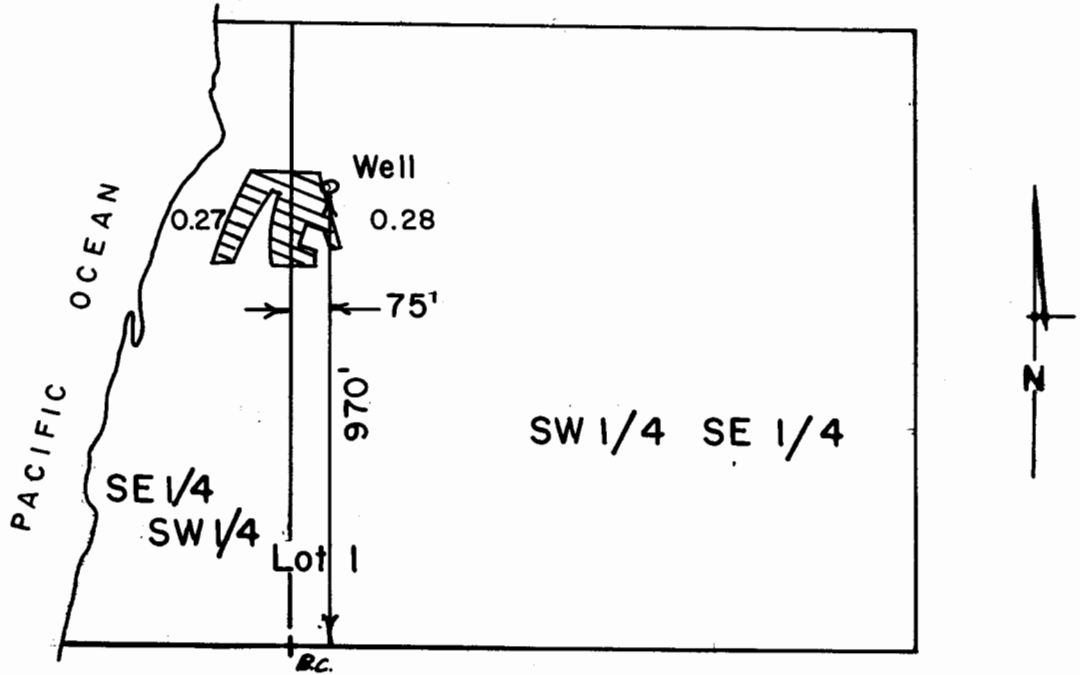

Scale 1" = 400'

FINAL PROOF SURVEY UNDER

Application No. G-11421. Permit No. G-10555
IN NAME OF

...WARREN & WILMA...AUSLAND

Surveyed Sept. 13, 1990, by M. Schmorde...