


T. 1 N., R. 22 E., W.M.

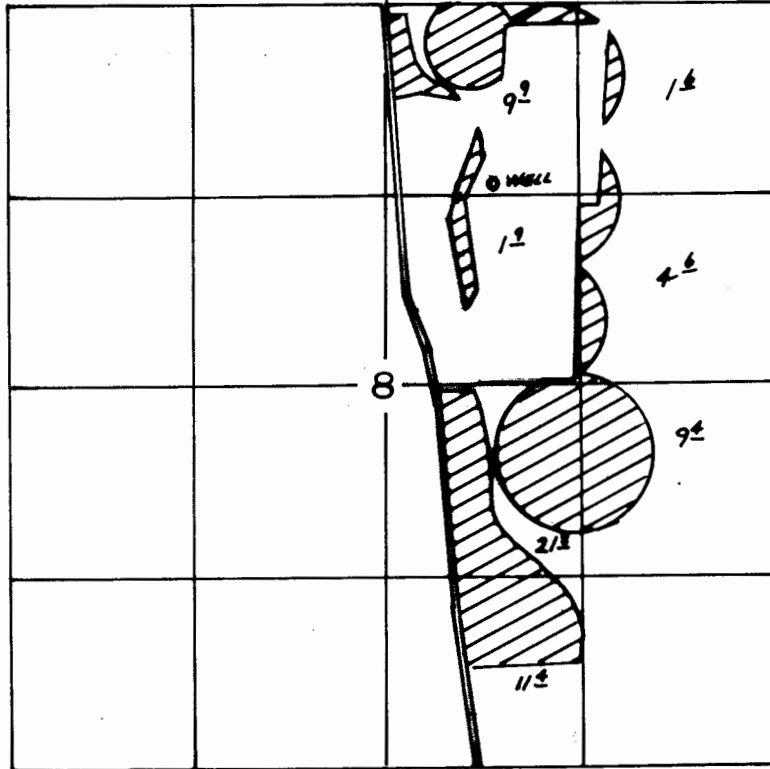

WELL - 1097.5' W. AND 1237.5' S. FROM THE N.E. COR.
SECTION 8.

FINAL PROOF SURVEY

UNDER

Application No. G-10536 Permit No. G-9911
IN NAME OF

WM. E. WEST

Surveyed 2-6, 1991, by K. KEMP

3-17-94 J.M 41021-279-262 R

Amended 7/3/03 GC