


Section 29, T. 55S, R. 5W, N.H.
 CLAIM OF BENEFICIAL USE MAP for TRANSFER 7124 - GEORGE SIMS

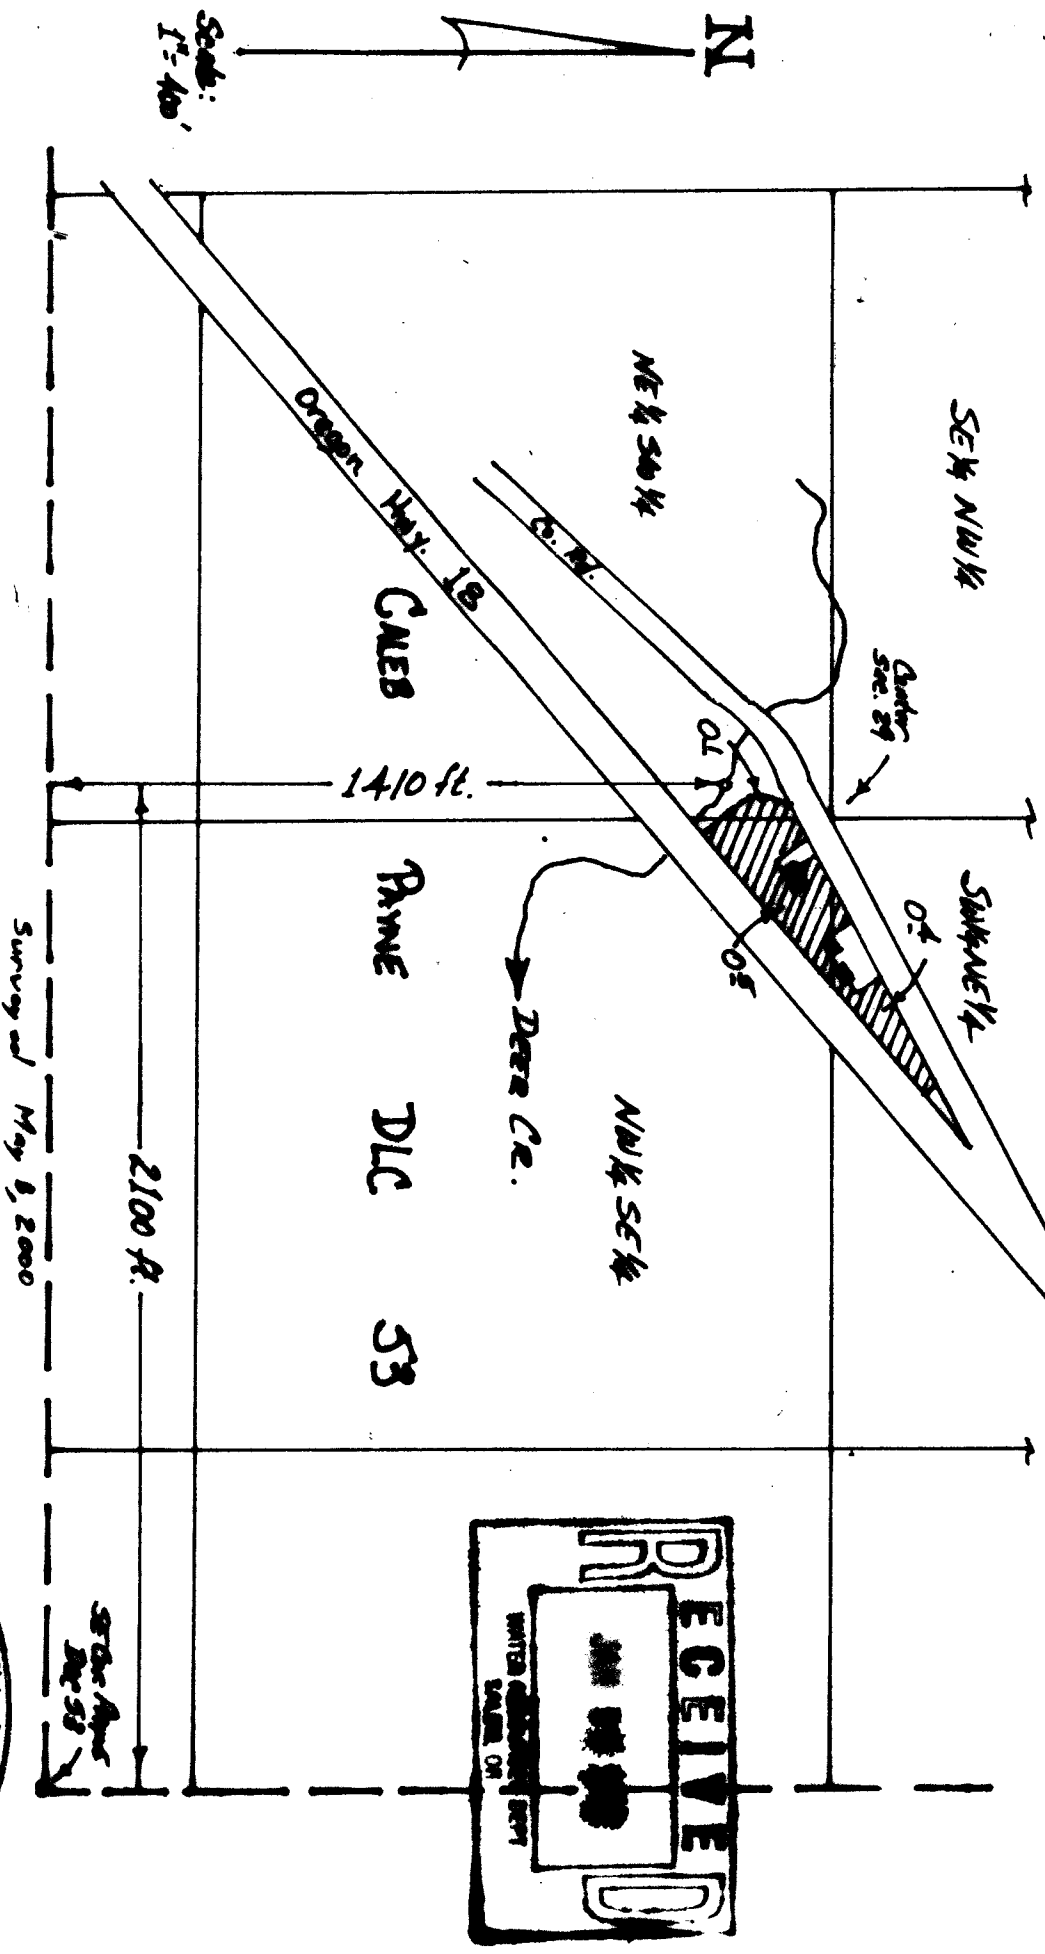

This map is for the purpose of locating a water right only and has no intent to provide legal dimensions or the location of property lines.

ESTES SURVEYS
 PO Box 17519
 Salem, OR 97305-7519
 (503) 588-7583


