T.30S., R.5W., W.M.

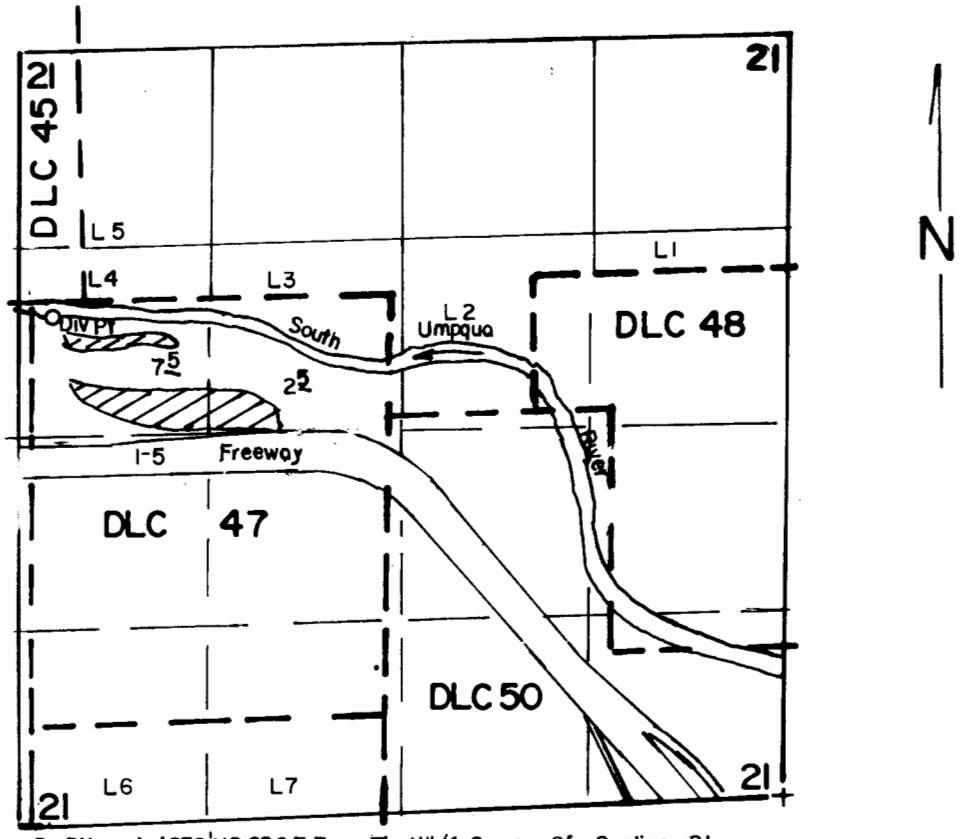

Div Pt Located 850' N & 220 E From The W1/4 Corner Of Section 21

FINAL PROOF SURVEY

UNDER

TRANSFER NO 5949

Application No. ..... **Permit No.** .....

IN NAME OF

LOIS M CLOUGH

Surveyed APRIL 4 **19**90, **by** B.S. JAMES

41019-278-223L 8-7-90 DLM