





T. 30 S., R. 4 W., W. M.

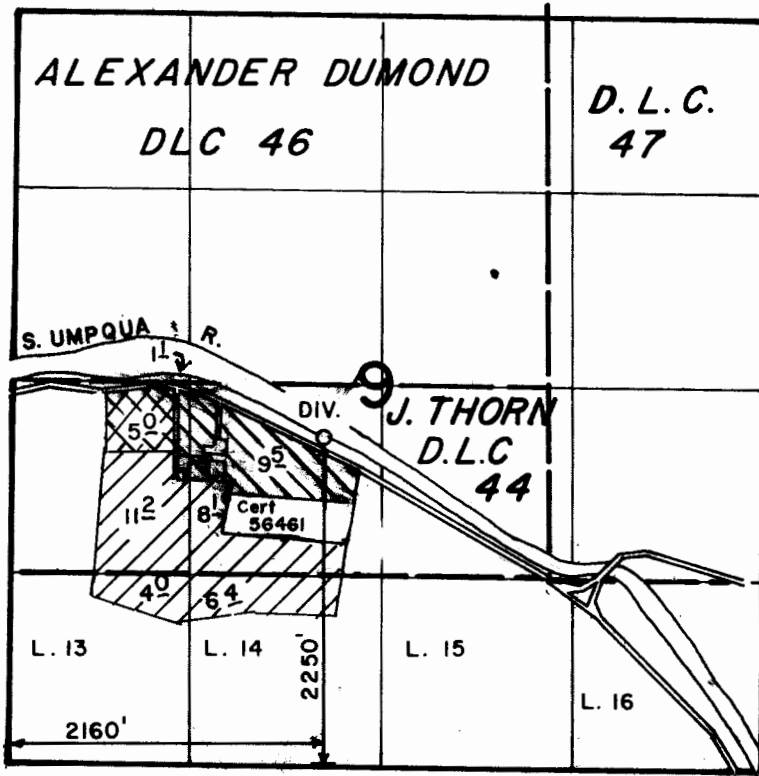

-  TRANSFER 5913
-  PERMIT 50068
-  TRANSFER 5914

SCALE: 4" = 1 MILE

**FINAL PROOF SURVEY**  
UNDER

Application No 69016      Permit No 50068

TRANSFER NUMBERS T-5913 & T-5914

IN NAME OF

**TOMMY M. AND NADEAN E. SMITH**

Surveyed AUG. 11..... 1987., by J.M. SCHMORDE...

APRIL 24    1990      B S JAMES

41019-378-292L  
30S, 4W, NW/ ZTS

8-9-90  
1/26/89

DLM  
jk