





T. 30 S., R. 4 W., W. M.

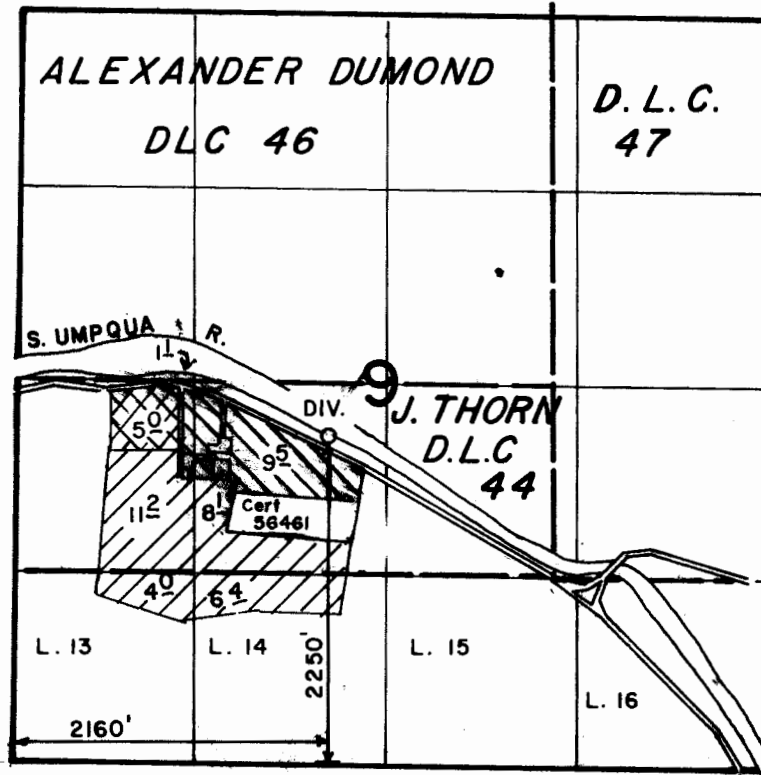

 TRANSFER 5913
 PERMIT 50068
 TRANSFER 5914

SCALE: 4" = 1 MILE

FINAL PROOF SURVEY
UNDER

Application No 69016 Permit No 50068

TRANSFER NUMBERS T-5913 & T-5914

IN NAME OF

TOMMY M. AND NADEAN E. SMITH

Surveyed AUG. 11..... 1987., by J.M.SCHMORDE..

APRIL 24 1990 B S JAMES

41019-378-292L
30S, 4W, NW/ ZTS

8-9-90
1/26/89

DLM
jk