


T.30S.R.4W.W.M.

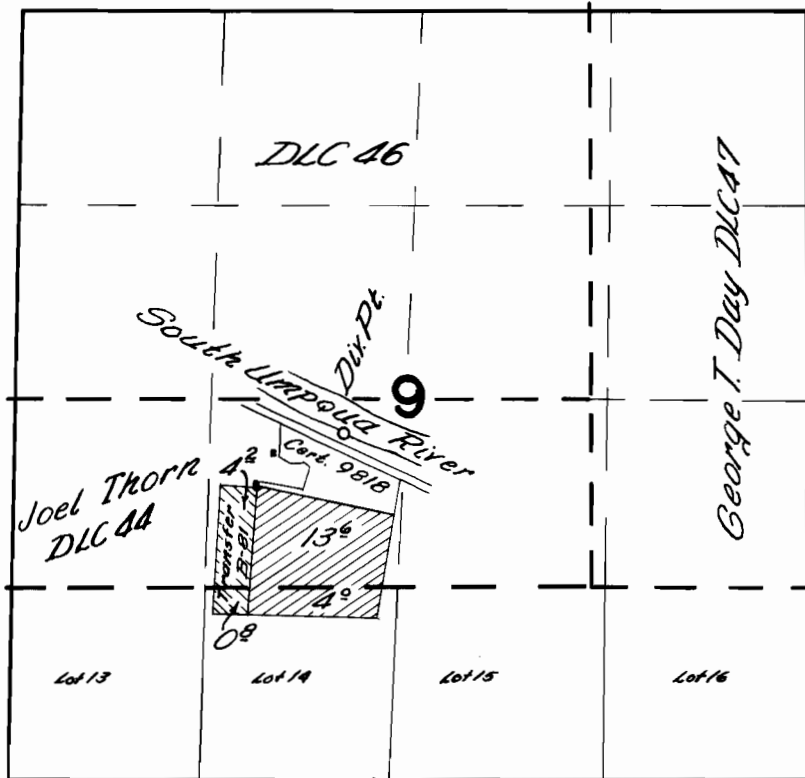

**FINAL PROOF SURVEY**  
UNDER

Application No. 25821 Permit No. 20288  
IN NAME OF

W. FRANK BROWN

Surveyed April 16 1957, by C. O. Smith