


# WATER RIGHT MAP FOR LOCATION CHANGE

SE1/4 SE1/4 SEC 1 T 38S R 48E W.M.

U.S.G.S. QUAD - BEAVER CHARLIE BREAKS, OREG. - 7 1/2'

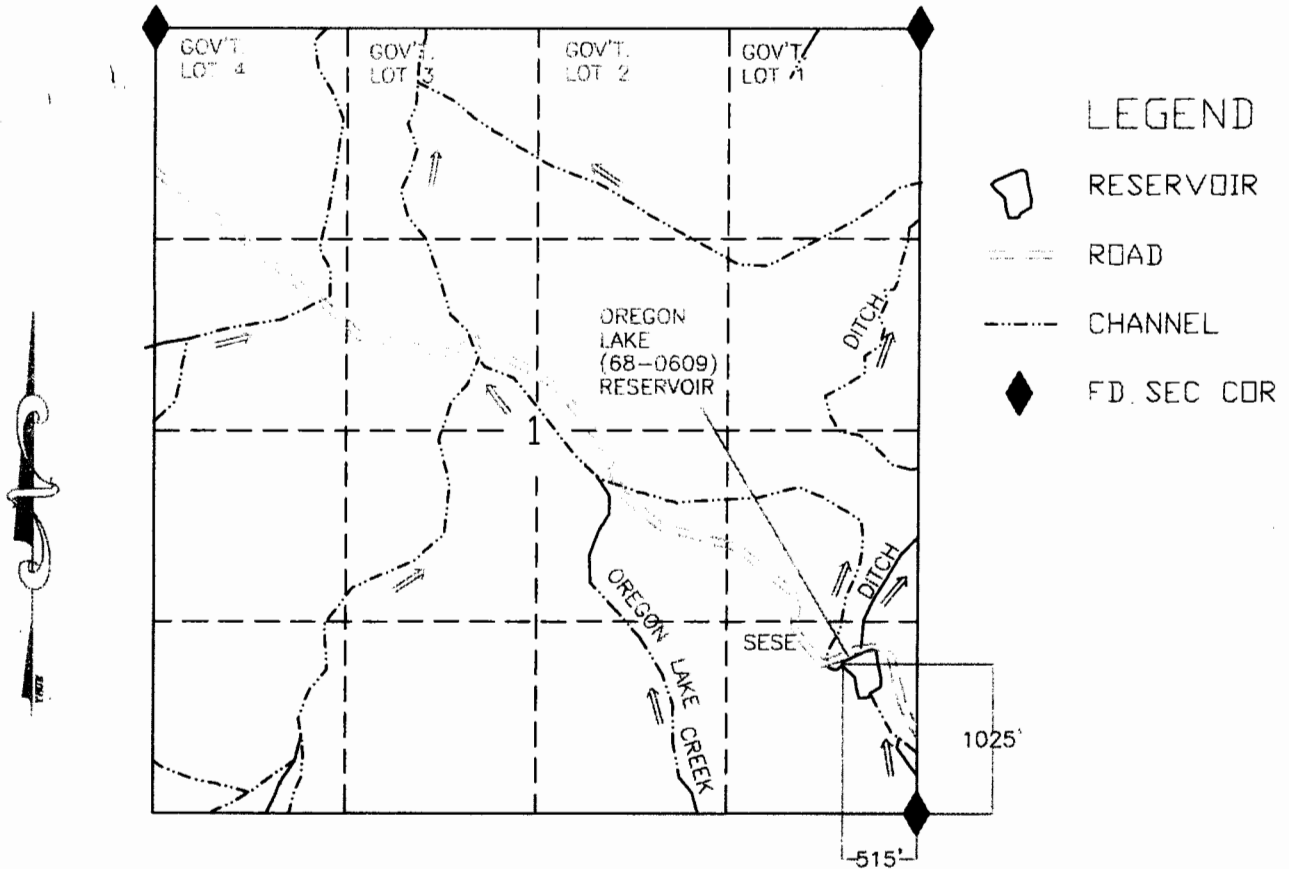


OREGON LAKE (68-0609) RESERVOIR

**RECEIVED**

JAN 09 2004

WATER RESOURCES DEPT  
SALEM, OREGON

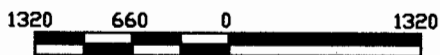

SCALE 1"=1320'

THIS MAP IS FOR THE PURPOSE OF LOCATING  
A WATER RIGHT AND IS NOT INTENDED TO  
PROVIDE LEGAL DIMENSIONS FOR LOCATION  
OF PROPERTY BOUNDARIES.



ACAD 13/SDSK  
DWG FILE: OREGON.LK.DWG

UNITED STATES DEPARTMENT OF THE INTERIOR  
BUREAU OF LAND MANAGEMENT  
DIVISION OF OPERATIONS VALE DISTRICT

OREGON LAKE  
(68-0609) RESERVOIR

|             |                                                         |                 |
|-------------|---------------------------------------------------------|-----------------|
| DESIGNED    |                                                         |                 |
| REVIEWED    |                                                         |                 |
| APPROVED    | <i>Thomson D. Perry</i><br>CHIEF, BRANCH OF ENGINEERING |                 |
| DRAWN       | CG                                                      | SCALE: 1"=1320' |
| DATE        | 12/19/94                                                | SHEET 1 OF 1    |
| DRAWING NO. | OR-03-9172.45-720                                       |                 |