
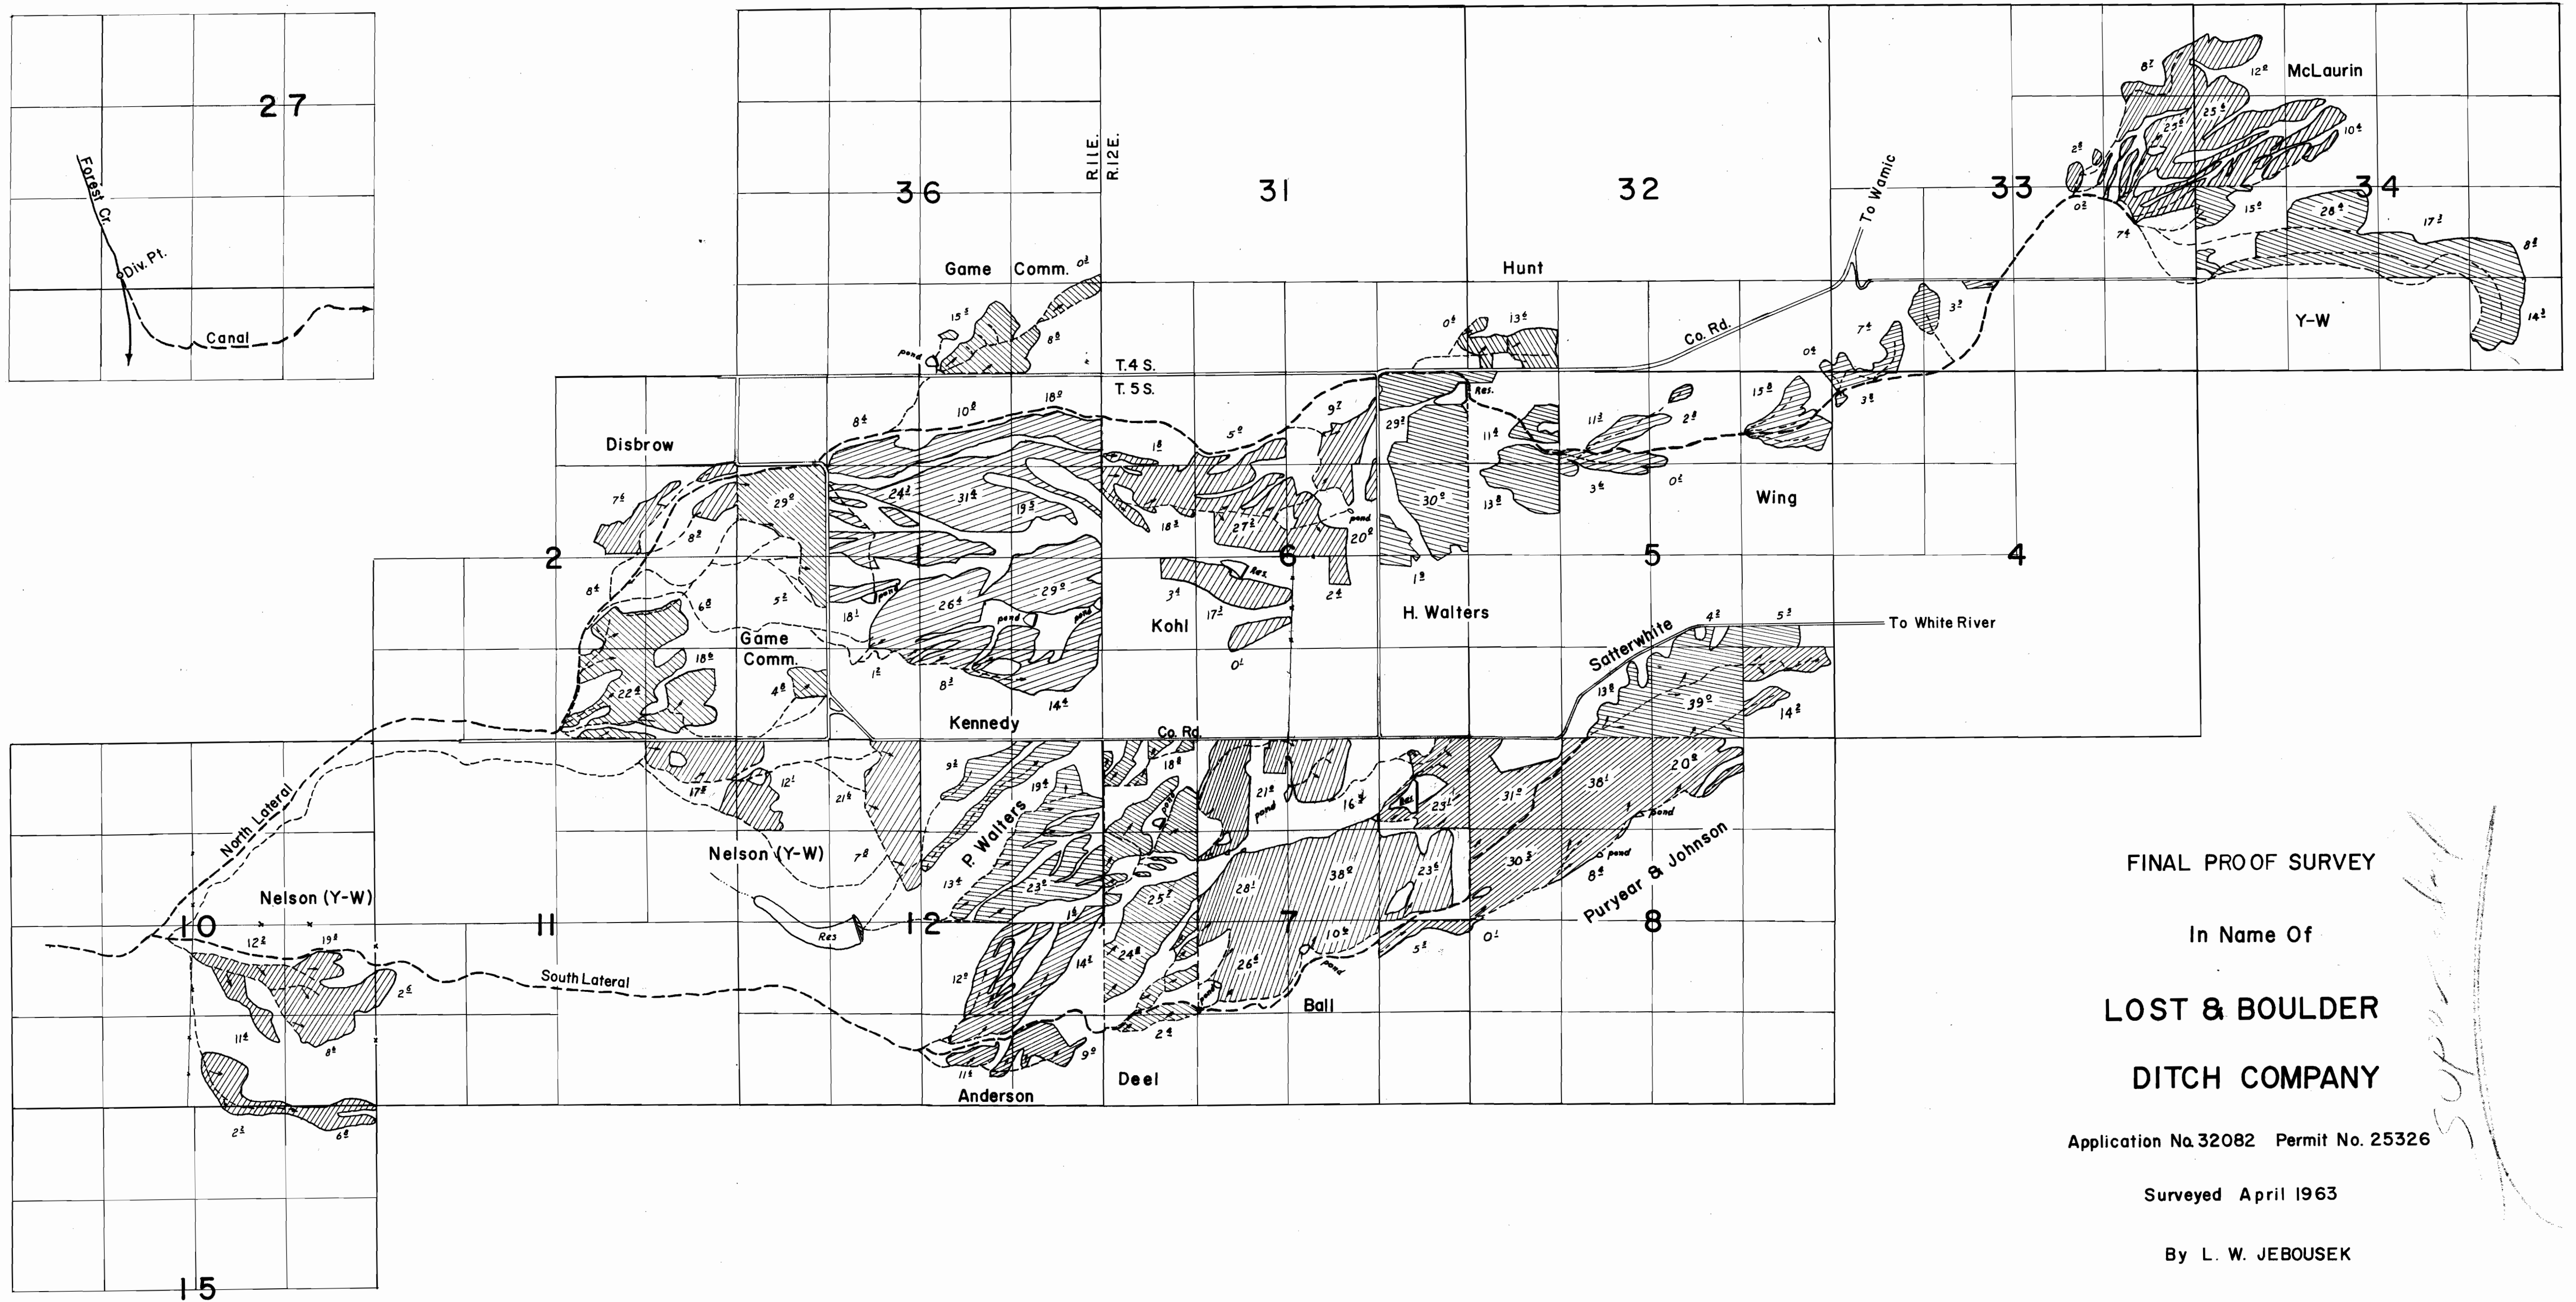


T. 4 S. R. 10 E. W.M.

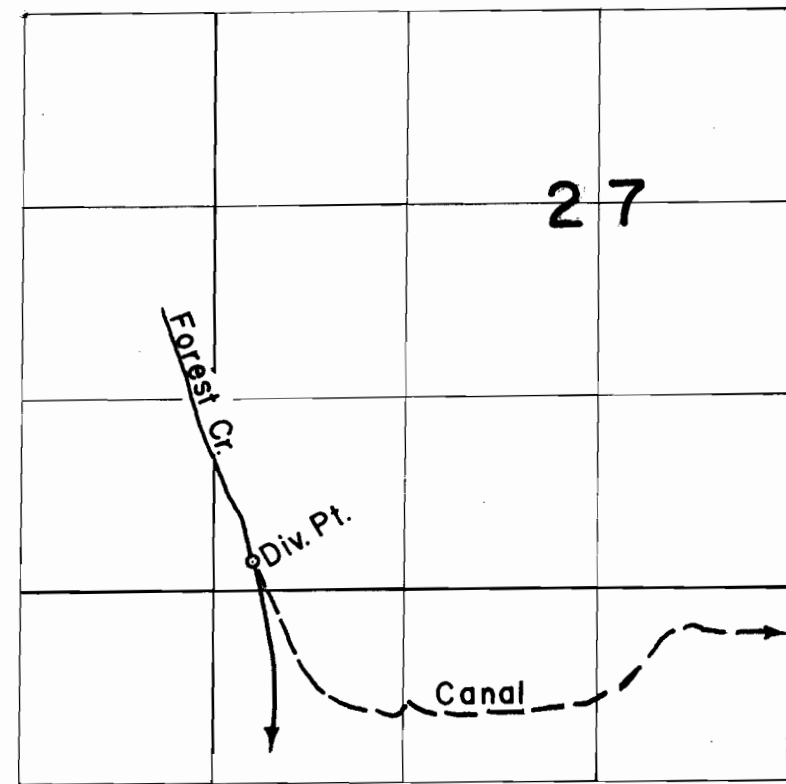

FINAL PROOF SURVEY

In Name Of

LOST & BOULDER

DITCH COMPANY

Application No. 32082 Permit No. 25326



Surveyed April 1963

By L. W. JEBOUSEK

Supplemental

MAP BELONGS
TO 32082
SS I E

T. 4 S. R. 10 E. W.M.

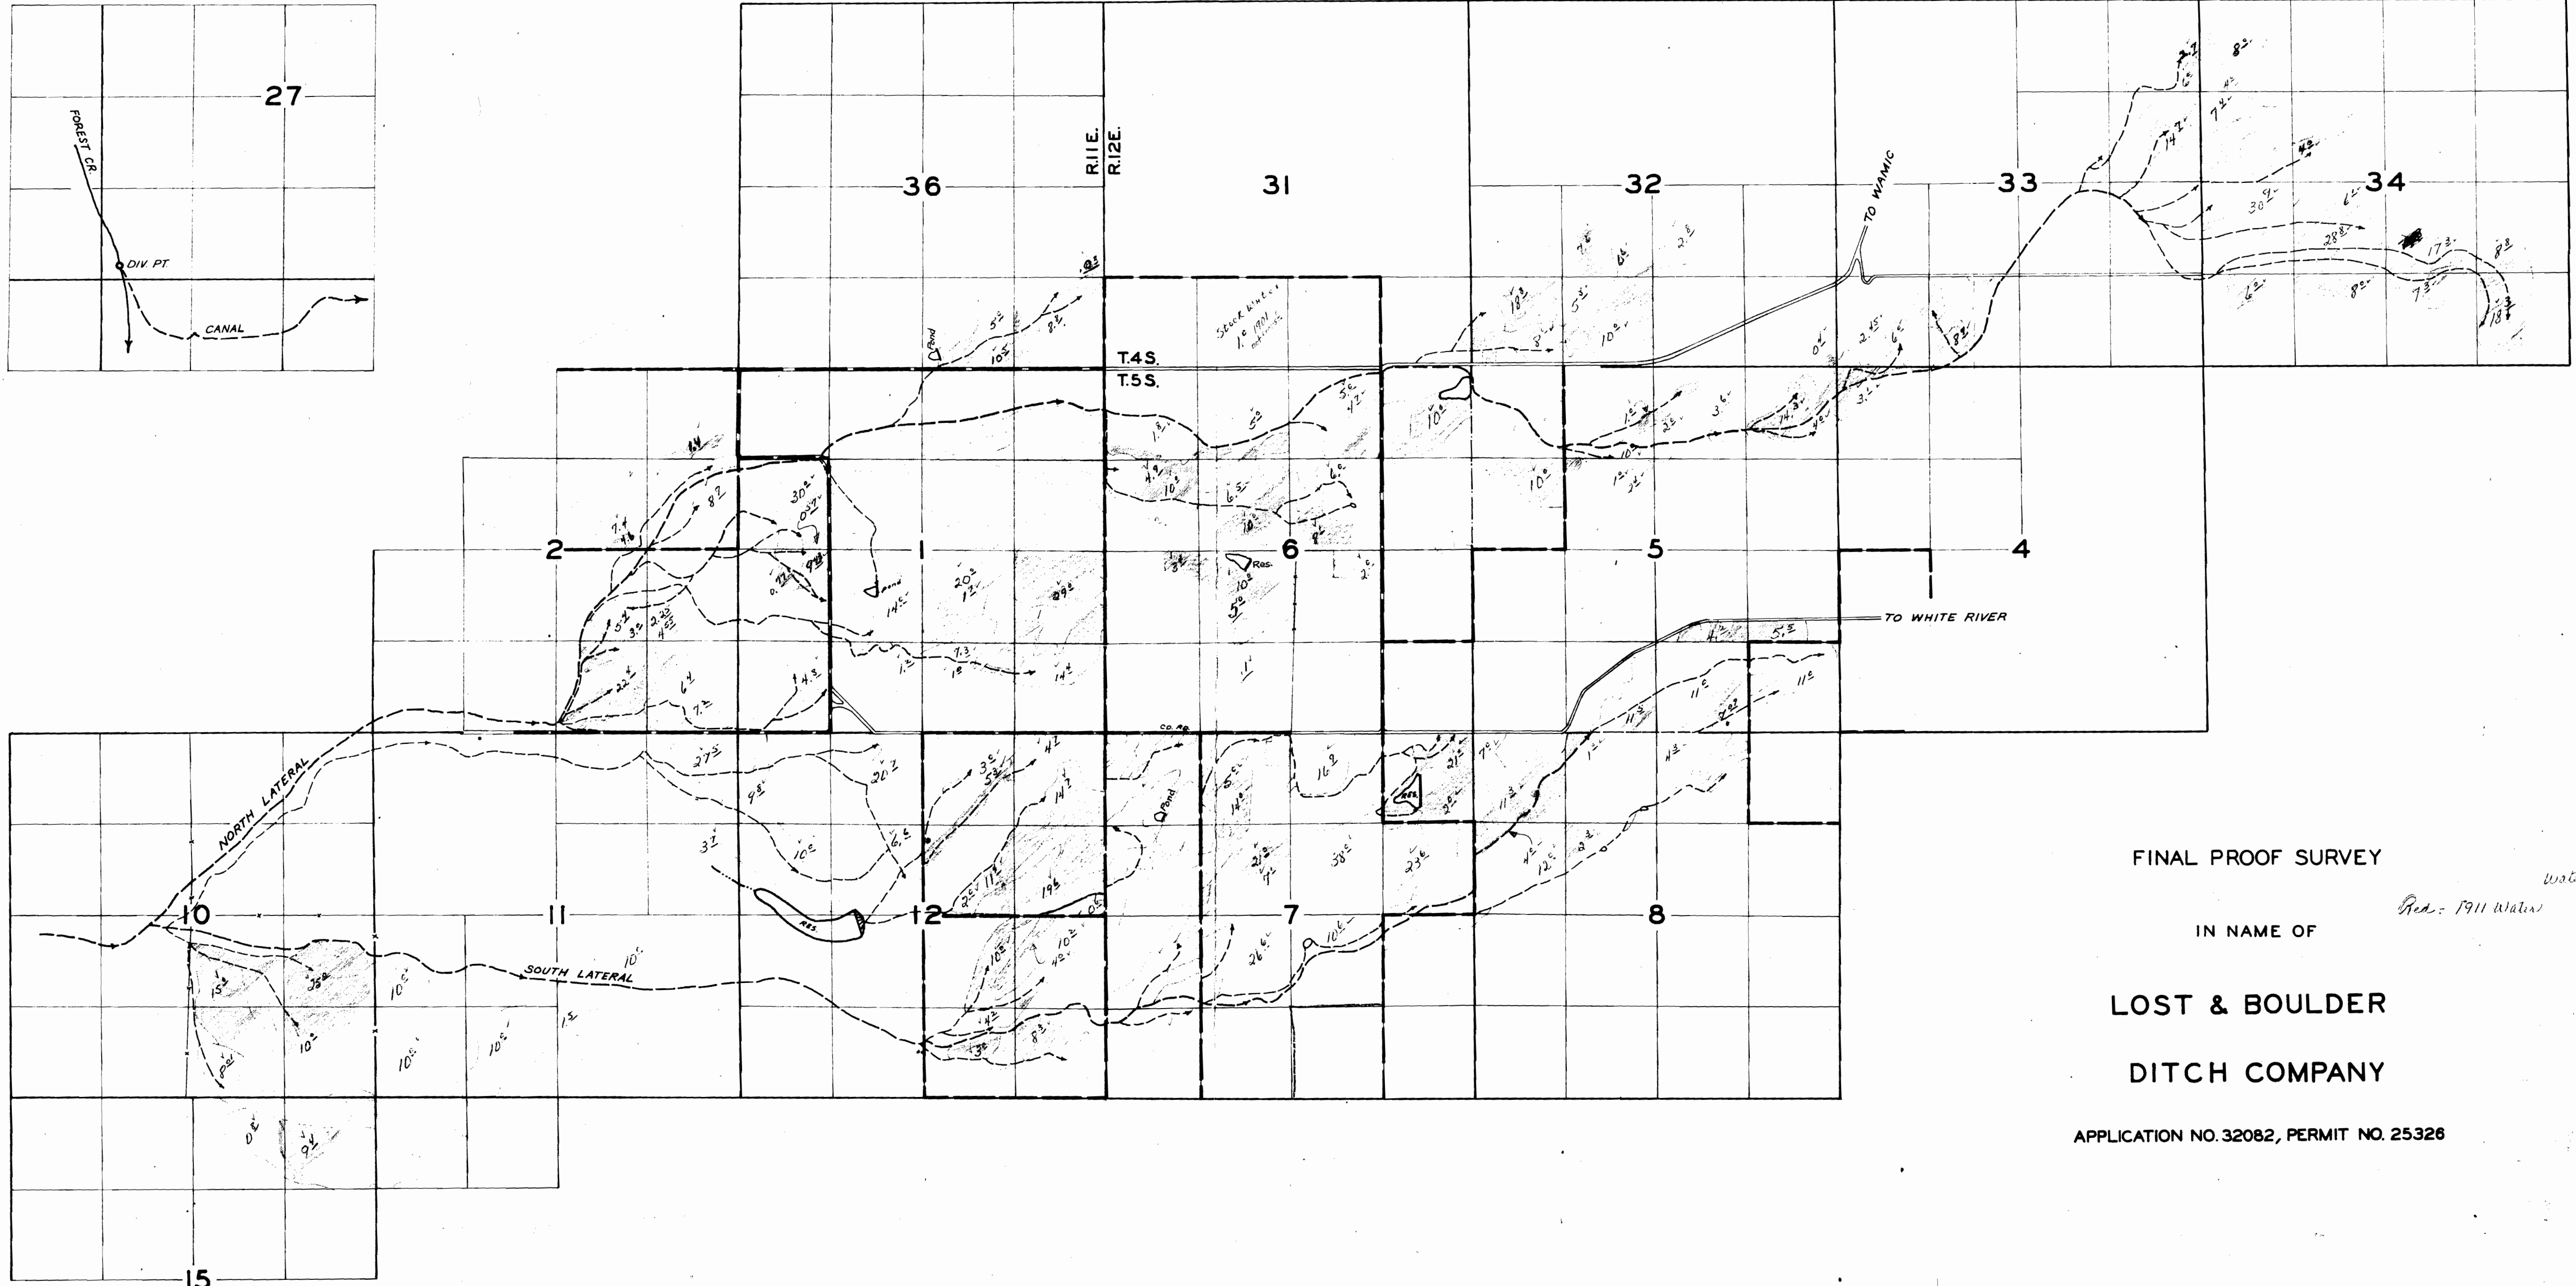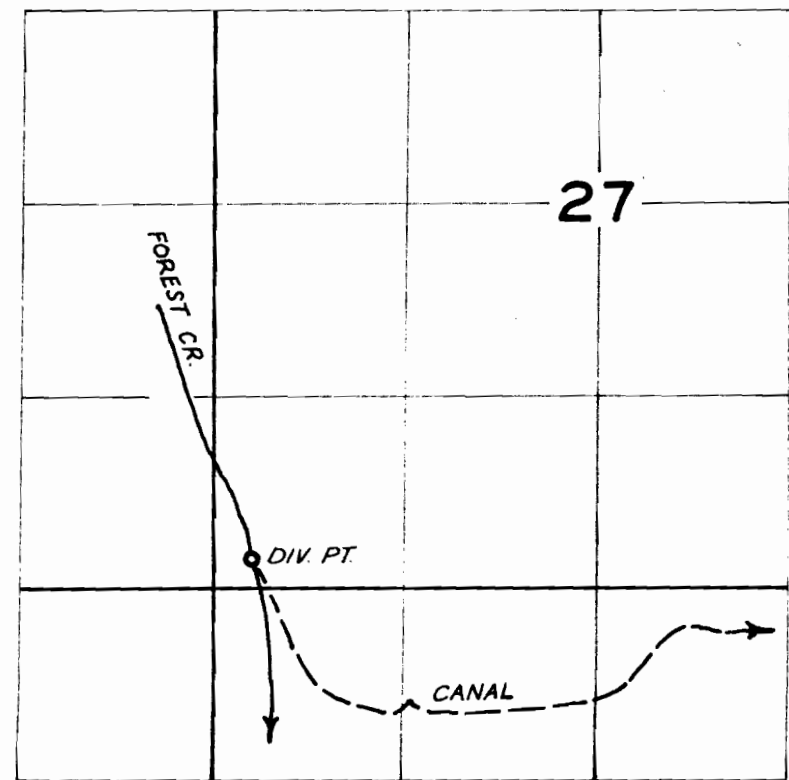

FINAL PROOF SURVEY

IN NAME OF

LOST & BOULDER

DITCH COMPANY

APPLICATION NO. 32082, PERMIT NO. 25326

Water
Red - 1911 Water

RECORDED
1917