


RECEIVED

JUL 19 2004

WATER RESOURCES DEPT
SALEM, OREGON

T.13S.R.6W.W.M.

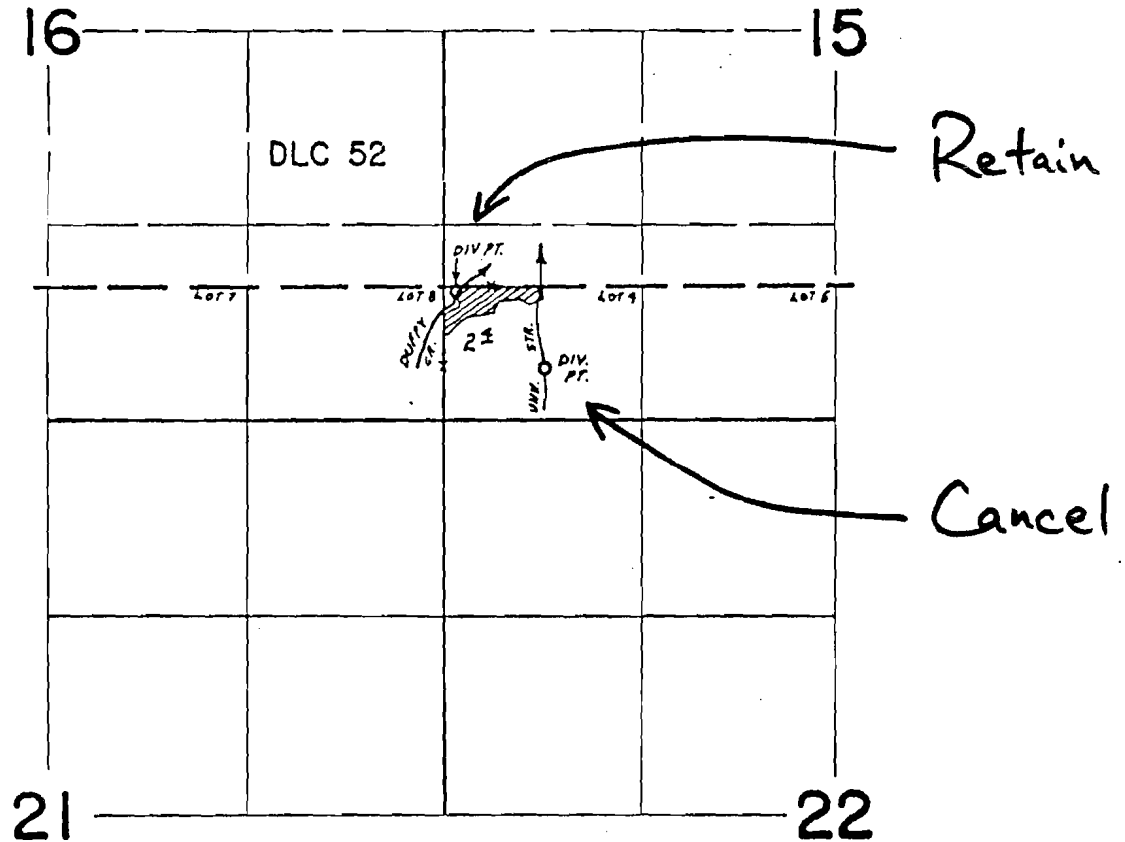

DIV. PTS. LOC.: DUFFY CREEK - 130'S & 90'E.; UNNAMED STREAM -
550'S & 670'E.; BOTH FROM NW COR. LOT 8

FINAL PROOF SURVEY

UNDER

Application No. 37296... Permit No. 27790...

IN NAME OF

Estate of WILLIAM H. KNUTH...

Surveyed JULY 30 19 70., by L. E. GOULD...