


T. 2 N. R. 30 & 31 E. W. M.

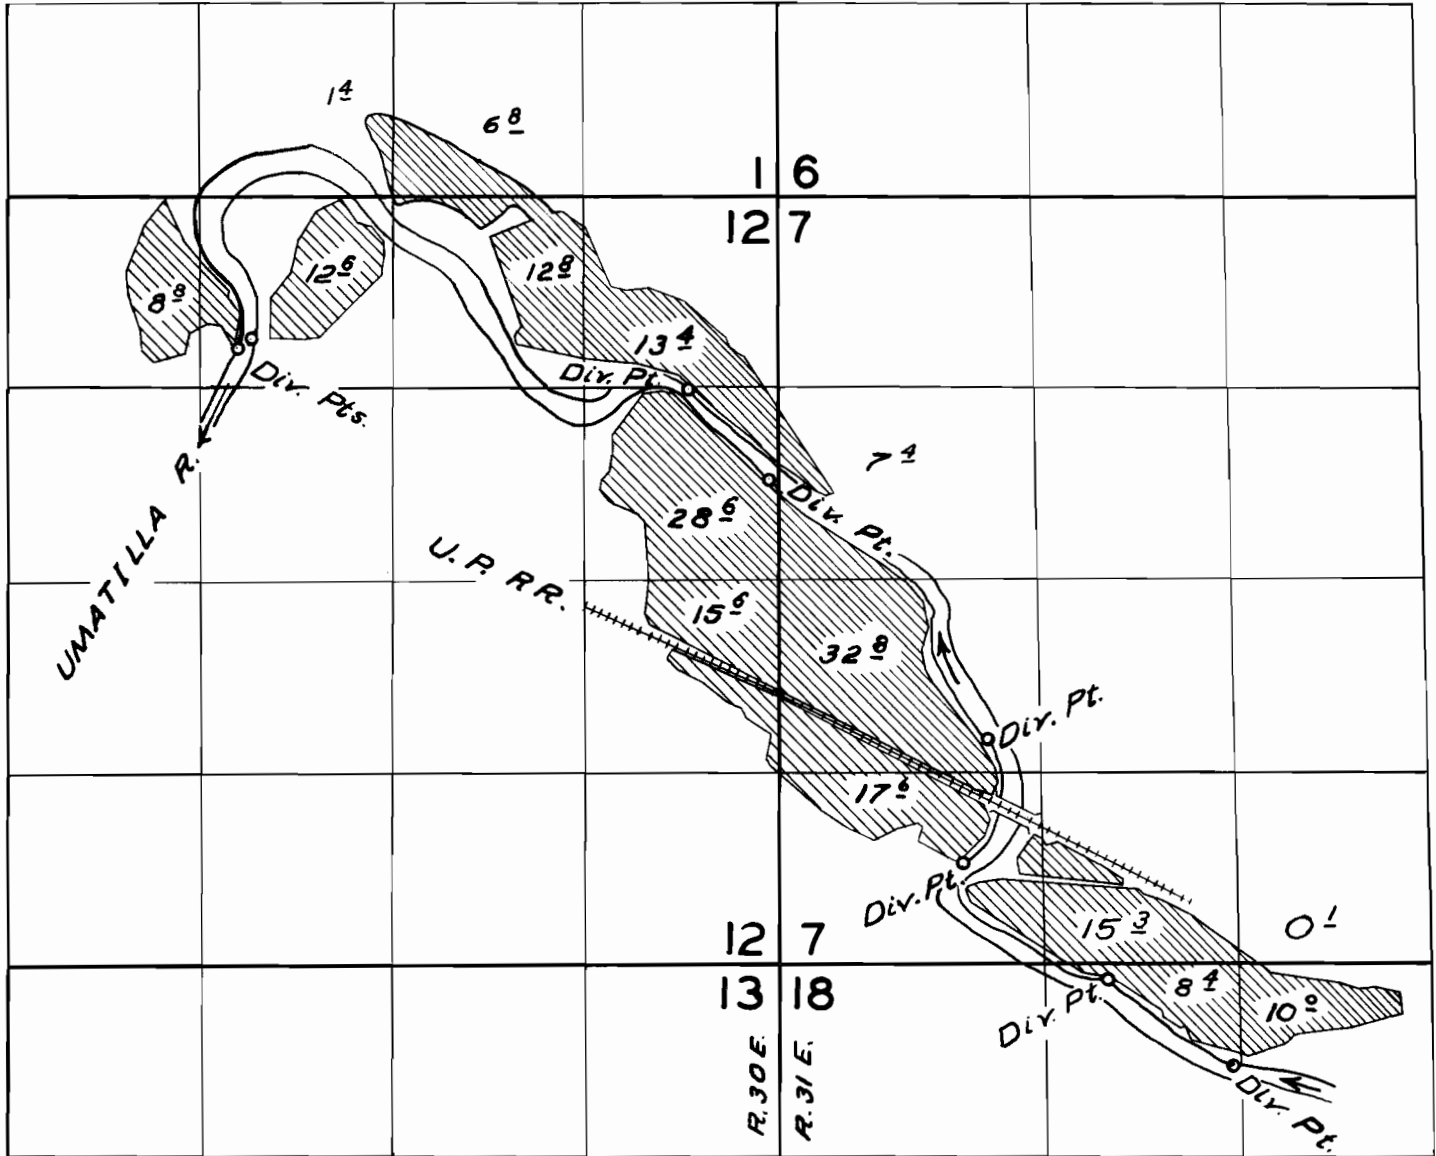

FINAL PROOF SURVEY UNDER

Application No. 20936 Permit No. 16393
IN NAME OF

E. E. Burlingham & Sons

Surveyed *May 30, 1958*, by *C. O. Bartels*
July 16, 1960, by *R. H. Jackson*