


T. 26S. R. 6W. W.M.

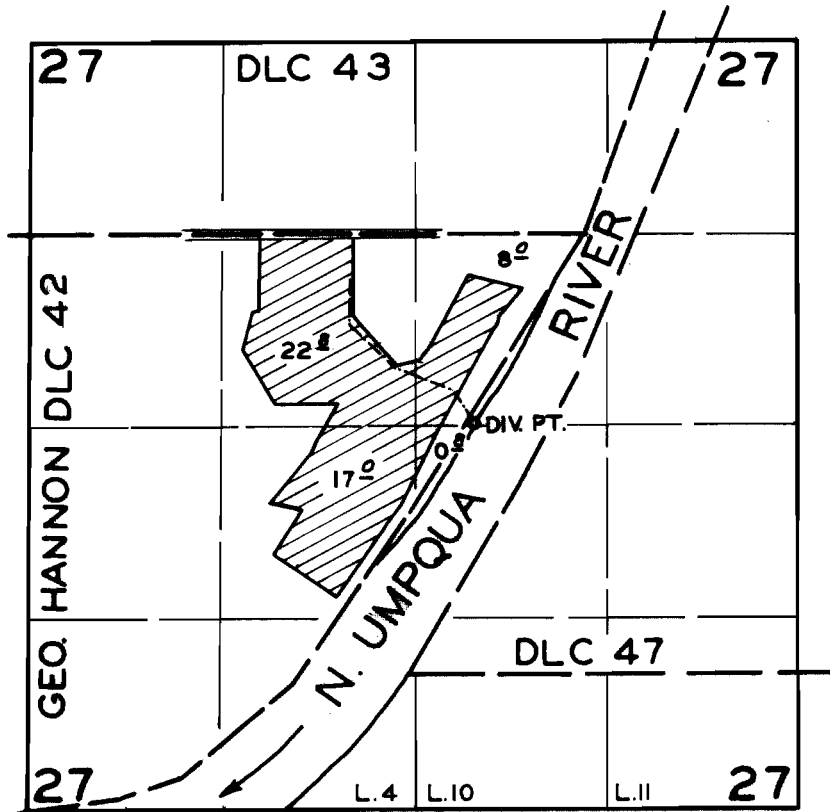

**FINAL PROOF SURVEY**  
UNDER

Application No. 30552 Permit No. 24057  
IN NAME OF

PETER J. PON

Surveyed AUG. 25, 1960, by C.O. BARTELS