


T13S, R1E, W.M.

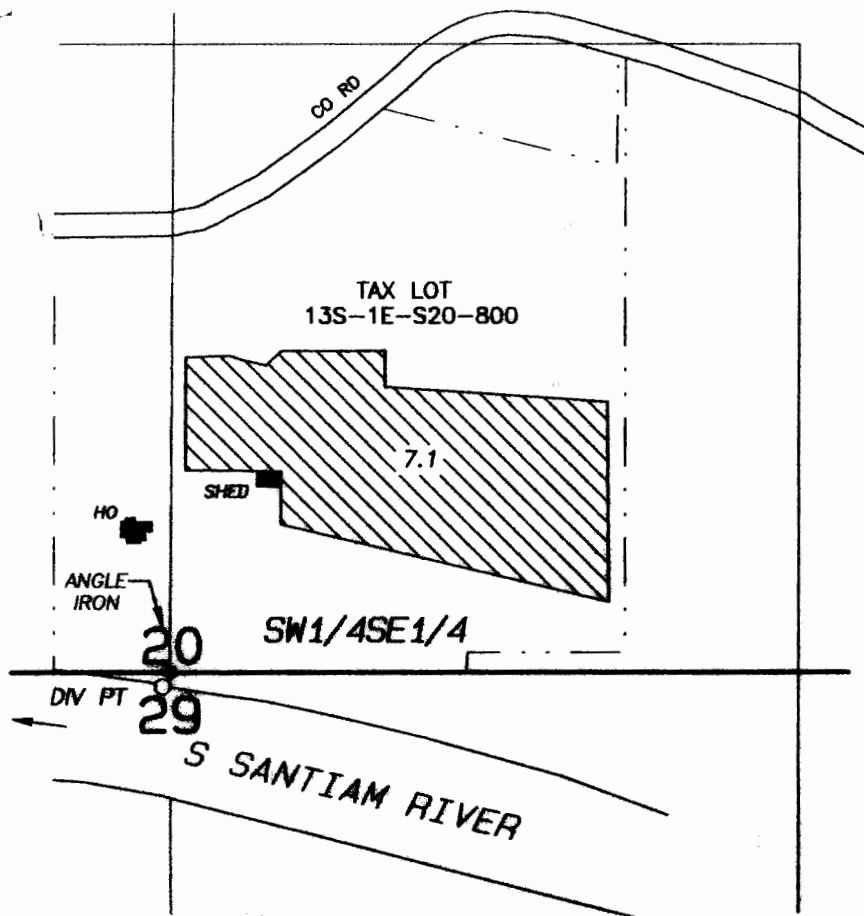

DIV PT: 30 FT SOUTH AND 16 FT WEST OF S 1/4 CORNER SEC 20

FINAL PROOF SURVEY MAP

UNDER

APPLICATION 8-71687 PERMIT 81782

IN THE NAME OF

CURTIS BROTHERS


PARSONS SURVEYING
1915 SE Stone St
Corvallis, OR 97333
(541) 752-7515
Project 0128
Surveyed: 9/10/2001
Rev: 1/16/2004

NOTE: This map is for the purpose of identifying the location of a water right and does not dimension or locate property ownership lines

RECEIVED

JAN 20 2004

WATER RESOURCES DEPT
SALEM, OREGON

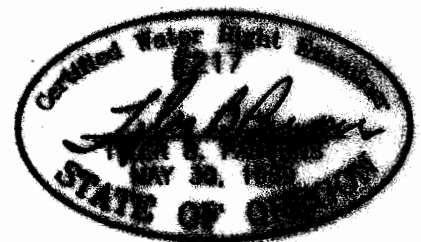

EXP: 12/31/2004