


Section 29, T. 5 S., R. 5 N., W. 4.

CLAIM OF BENEFICIAL USE MAP for Transfer 7724 - GEORGE STASTNY

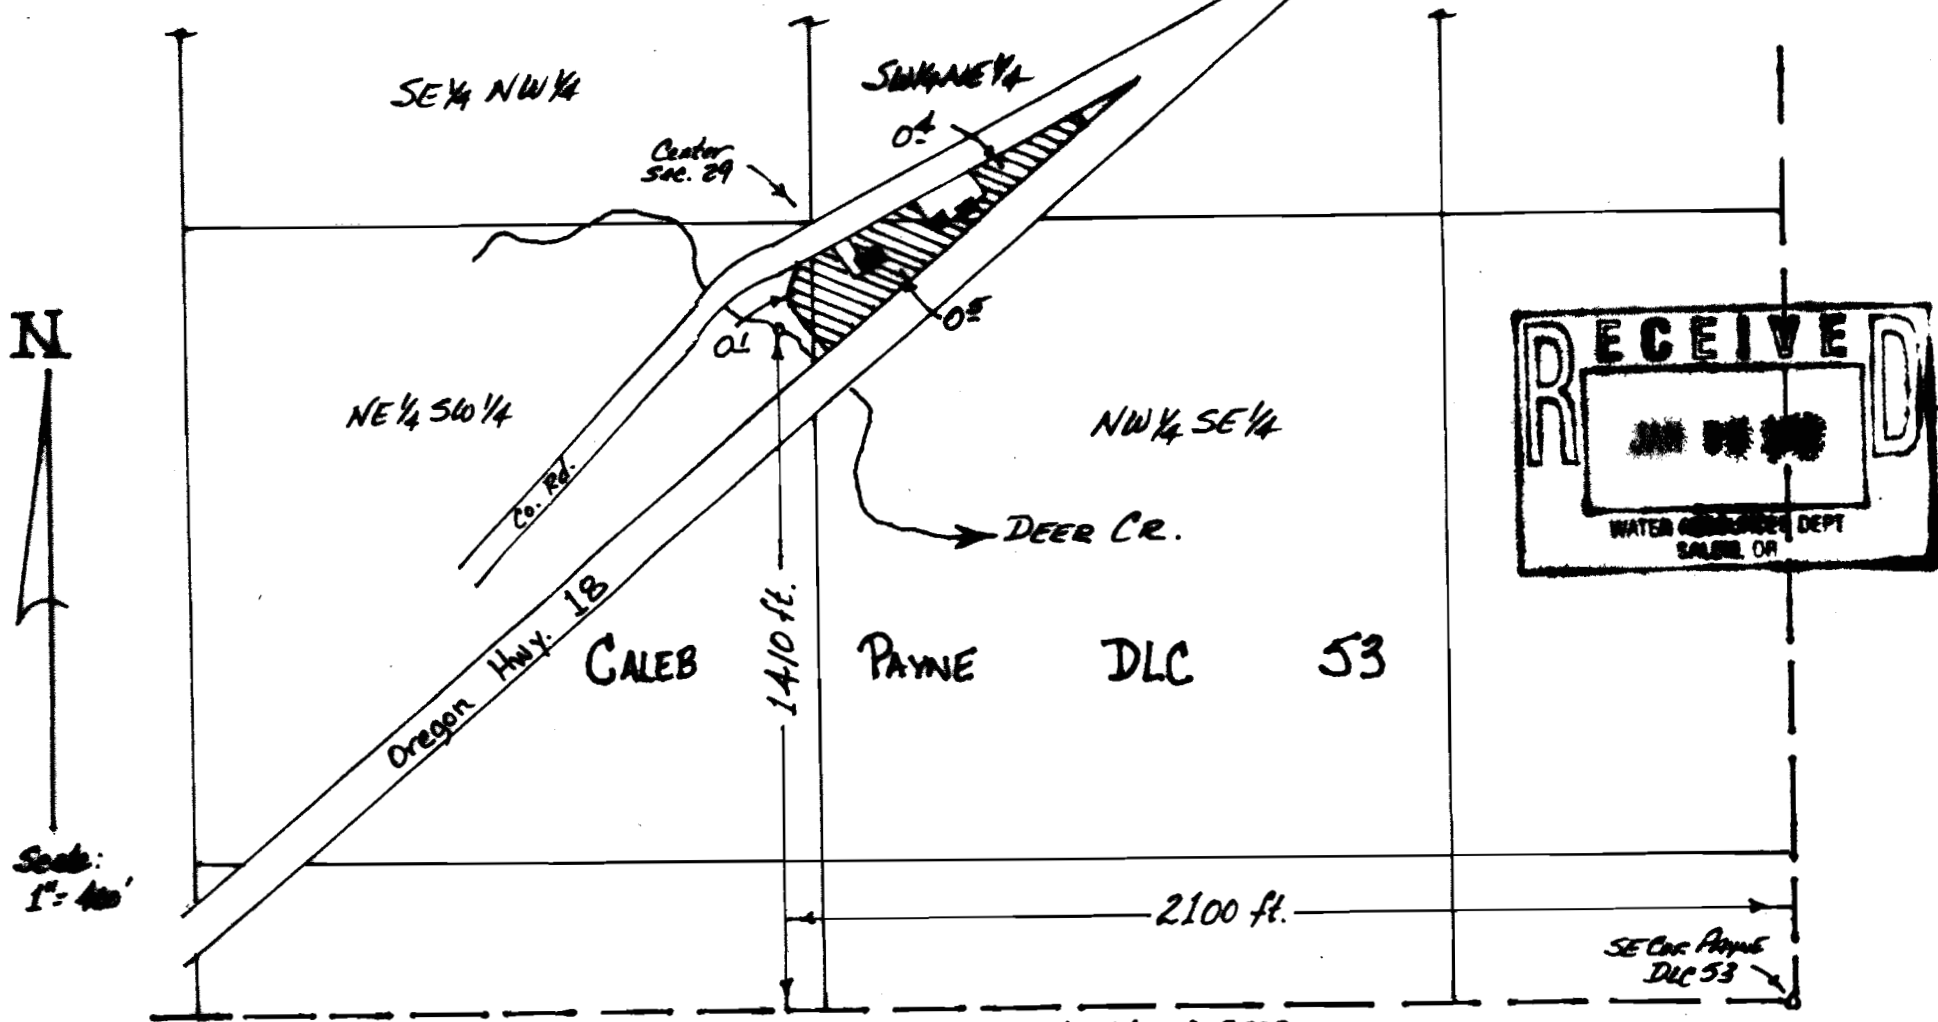

Surveyed May 8, 2000

This map is for the purpose of locating a water right only and has no intent to provide legal dimensions or the location of property lines.

ESTES SURVEYS
 PO Box 17519 60382 Arnold Rd
 Salem, OR 97305-7519 Bend, OR 97702
 (503) 585-7593 (541) 382-7391

Certified Water Right Examiner
 #1
Bruce A. Estes
 Bruce A. Estes
 Nov. 19, 1987
STATE OF OREGON
 Renewal Dec 31, 2001

DRAWN BY S.P.A.