


Township 6 South, Range 1 West, W.M.

RECEIVED

JAN 10 1995

WATER RIGHTS DIVISION DEPT. OF AGRICULTURE
SALEM, OREGON

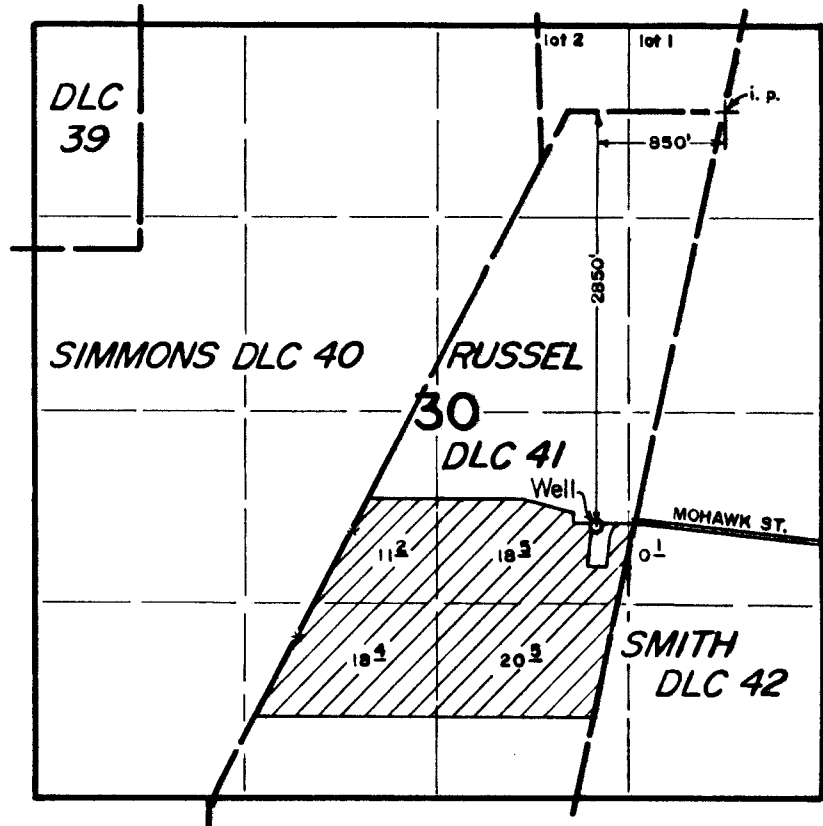

FINAL PROOF SURVEY


UNDER

APPL. No. G-12394, PER. No. G-11303

IN NAME OF

EDER BROTHERS, INC.

JANUARY 5, 1995

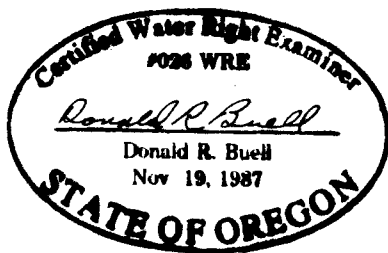

THIS MAP WAS PREPARED FOR THE PURPOSE OF IDENTIFYING THE LOCATION OF A WATER RIGHT ONLY AND IS NOT INTENDED TO PROVIDE LEGAL DIMENSIONS OR LOCATION OF PROPERTY OWNERSHIP LINES.