

27

TOWNSHIP 36 S, RANGE 11 E, W. M.

R 12925
RECEIVED 80589


FEB 29 2004

North

RECEIVED

DEC 10 2001

WATER RESOURCES DEPT.
SALEM, OREGON

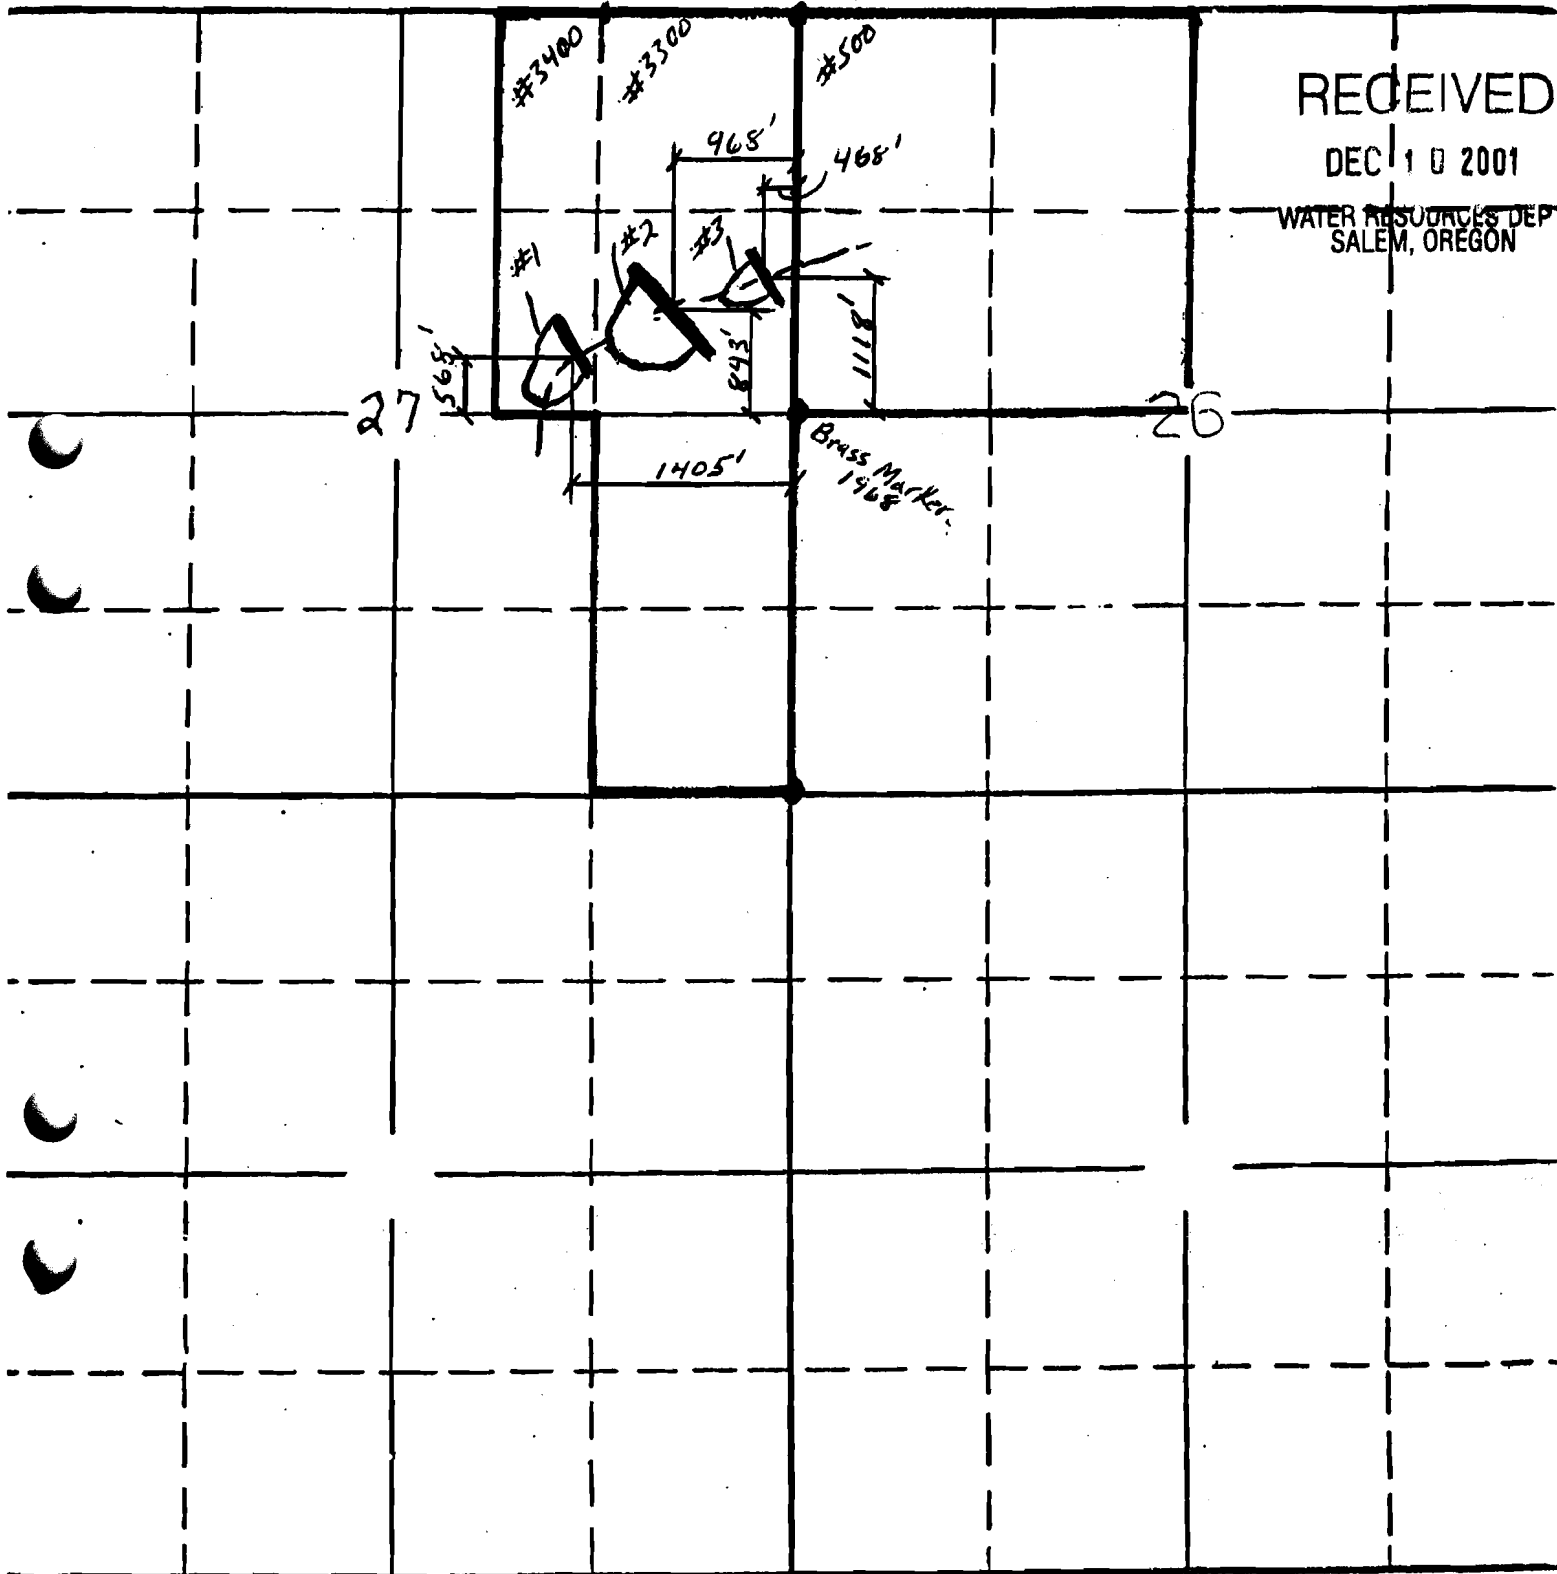

South


CODY ROBERT HOFFMAN

HIGH SERENITY RANCH

3/1/2000

APPLICATION No.

PERMIT No.

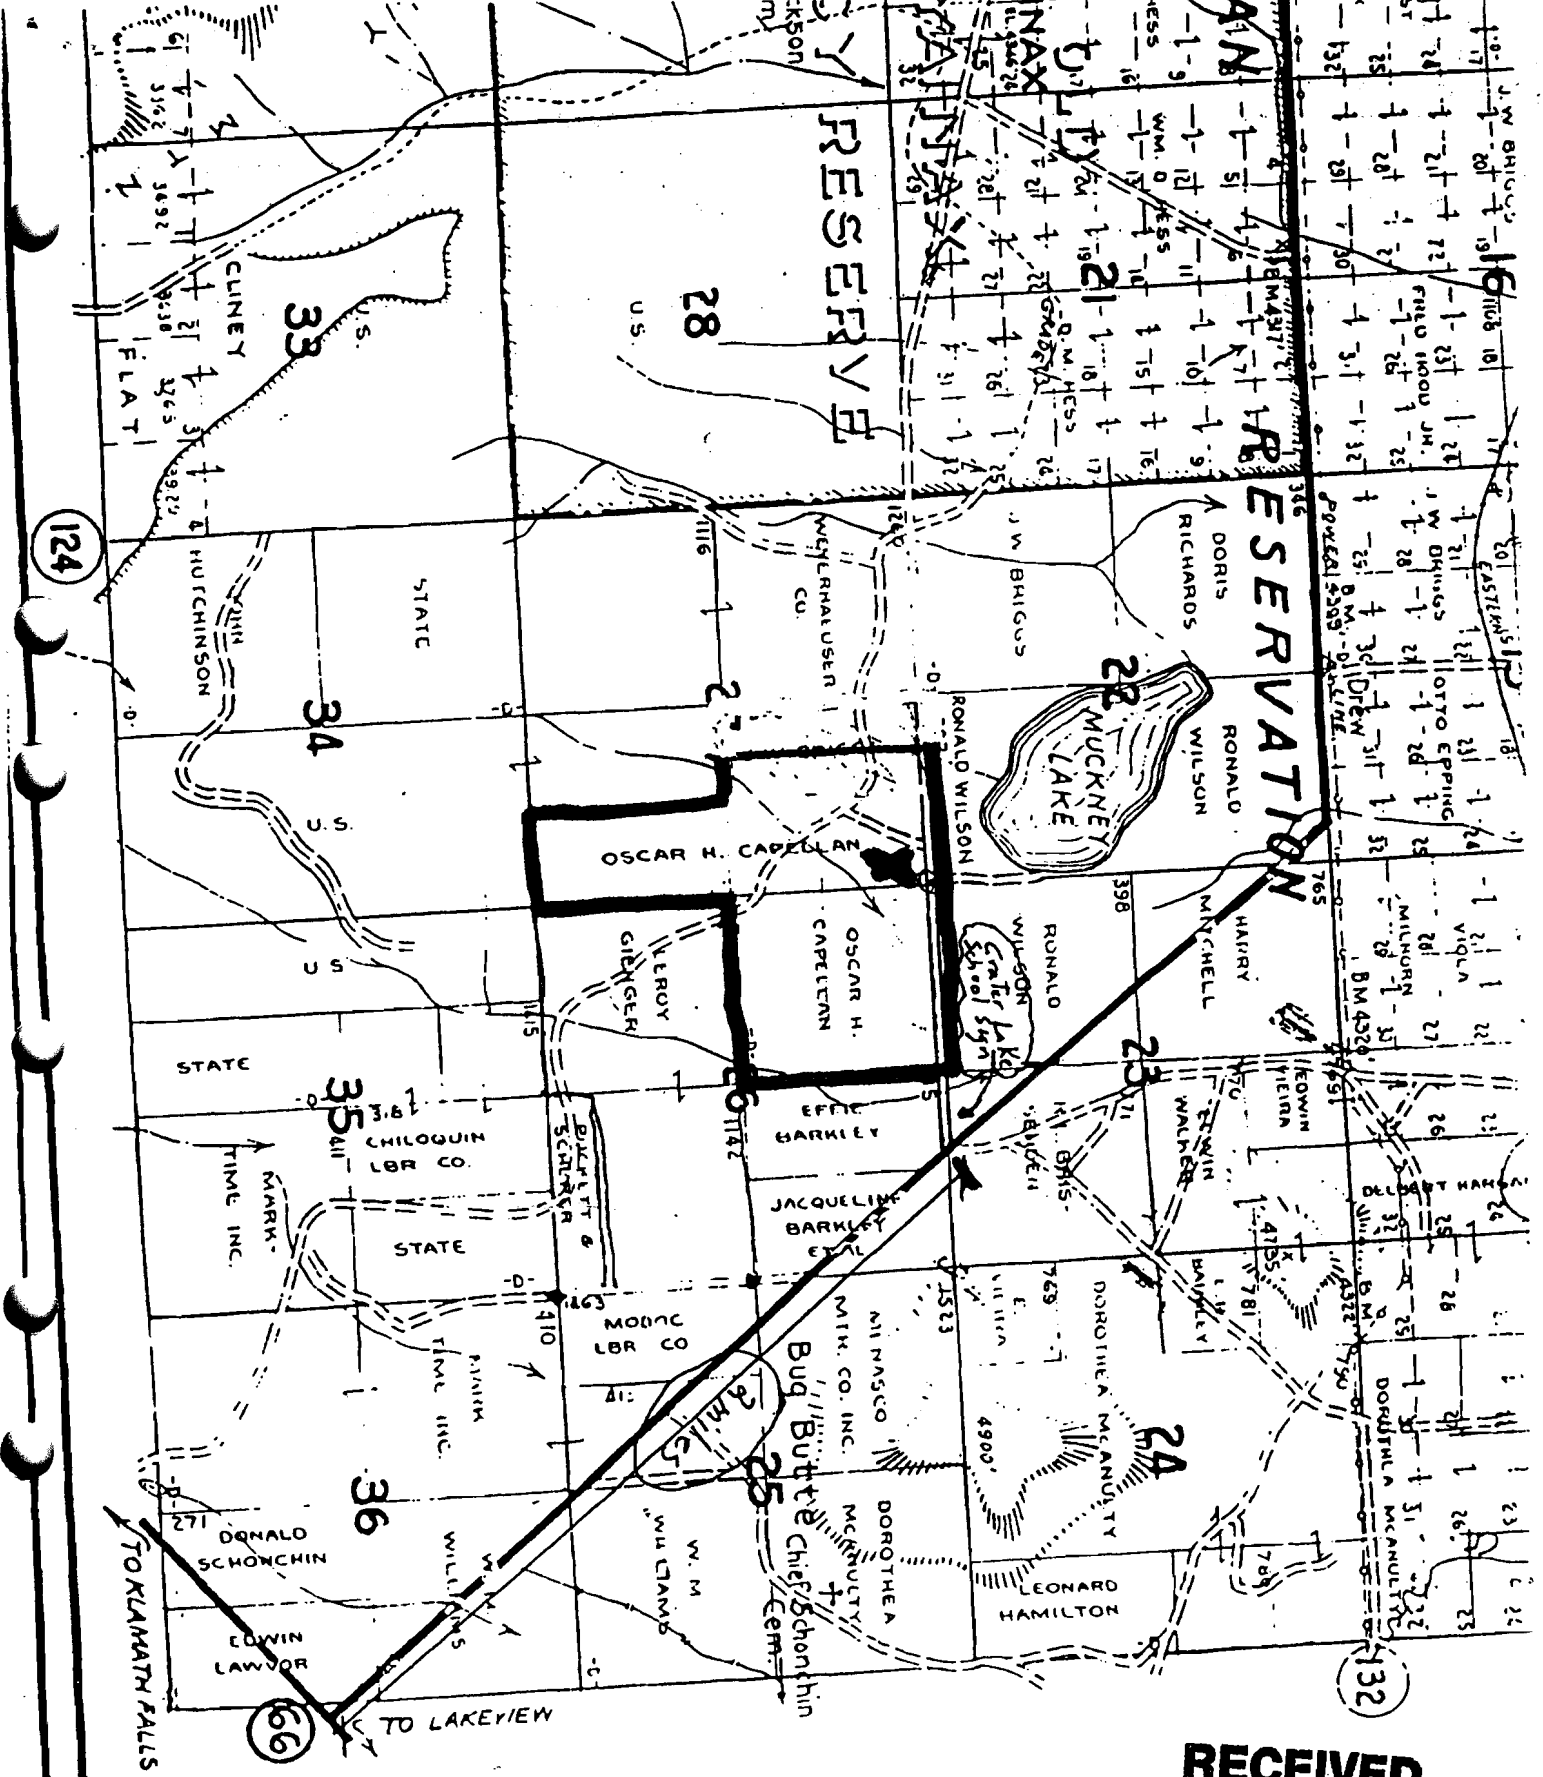

RECEIVED

MAR 9 2000

Application No. R-84369

Permit No. R-12925

WATER RESOURCES DEPT.
SALEM, OREGON

- 1
- PAYED ROAD
- STATE HWY
- IMPROVED
- DIRT ROAD
- INFERIOR
- RAILROAD
- TRAILS
- INTERMITT
- SCHOOLS