


T.6S.,R.1W.,W.M.

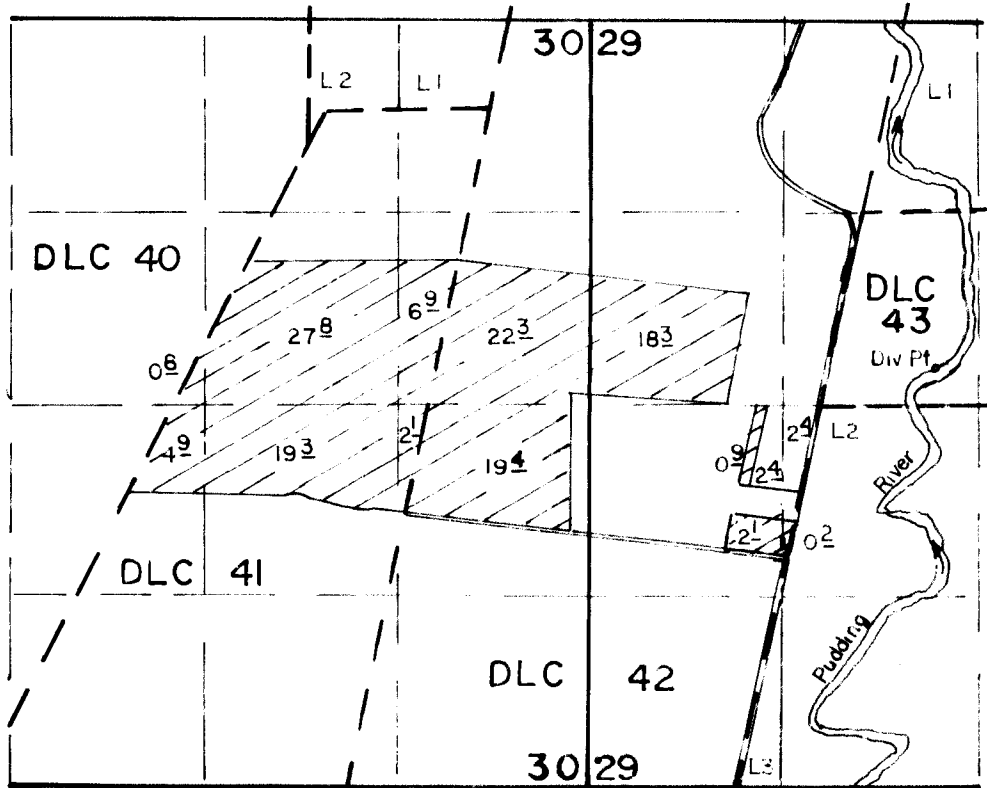

Div Pt Located 200' N & 830' E From The SW Corner Of DLC 43

SCALE: 1"=1320'

**FINAL PROOF SURVEY**  
UNDER

Application No. 6870.5. Permit No. 50736.....  
IN NAME OF

.....EDER.....BROTHERS.....

Surveyed MAY.23. 19.90., by J.M.WARREN....