
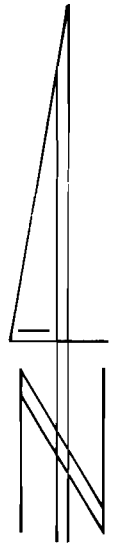


# T. 1N., R. 2E., W. M.

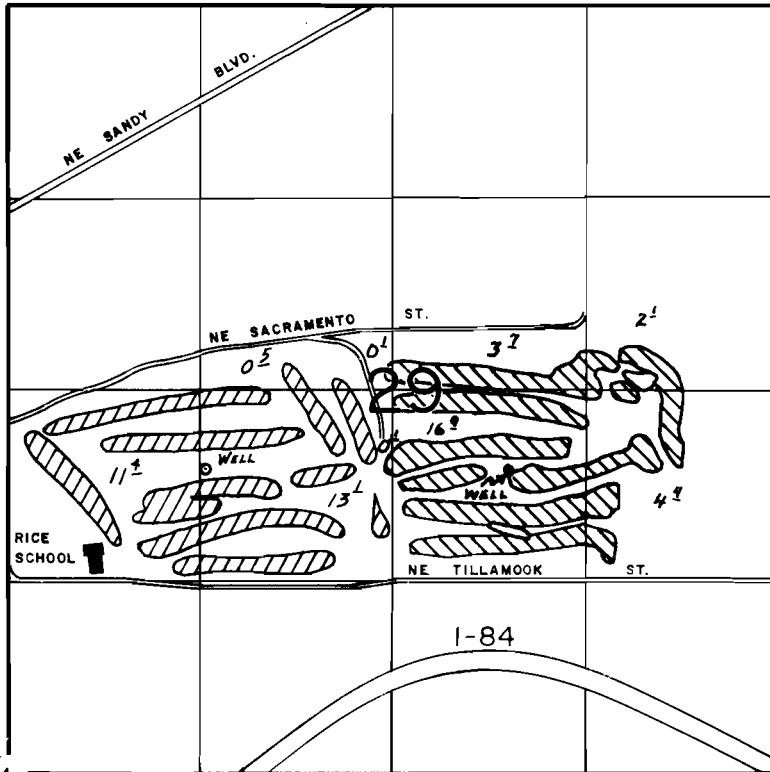

1" = 1320'

SW  
SFC. Cor.  
SPIKE  
IN Rd.

WELL LOC. 2100' N. & 1350' E. FROM SW COR. SEC. 29. - PERMIT G-3767  
 2080' N. & 3420' E. " - PERMIT G-3773



## FINAL PROOF SURVEY UNDER

Application No. G-4137 Permit No. G-3773  
G-4015 Permit No. G-3767  
 IN NAME OF

BUREAU OF PARKS, CITY OF PORTLAND

Surveyed AUG 11 93 by R.W. KLASSEN  
APR 2 1980, by R.G. MUCKEN

41051 389 146 L  
 12/93 RVK  
 DFO-3LL-83  
 BMB