


T. 19 S., R. 26 E., W.M.

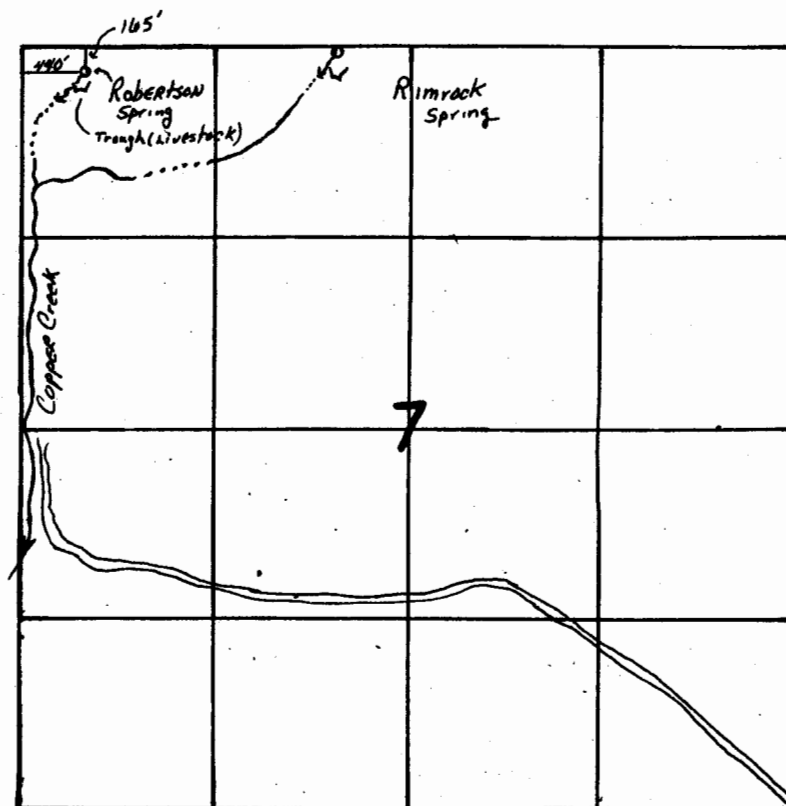

SCALE - 4" = 1 MILE

Application No. 67551
Permit No. 50810