


# T.6S. R.2W.W.M.

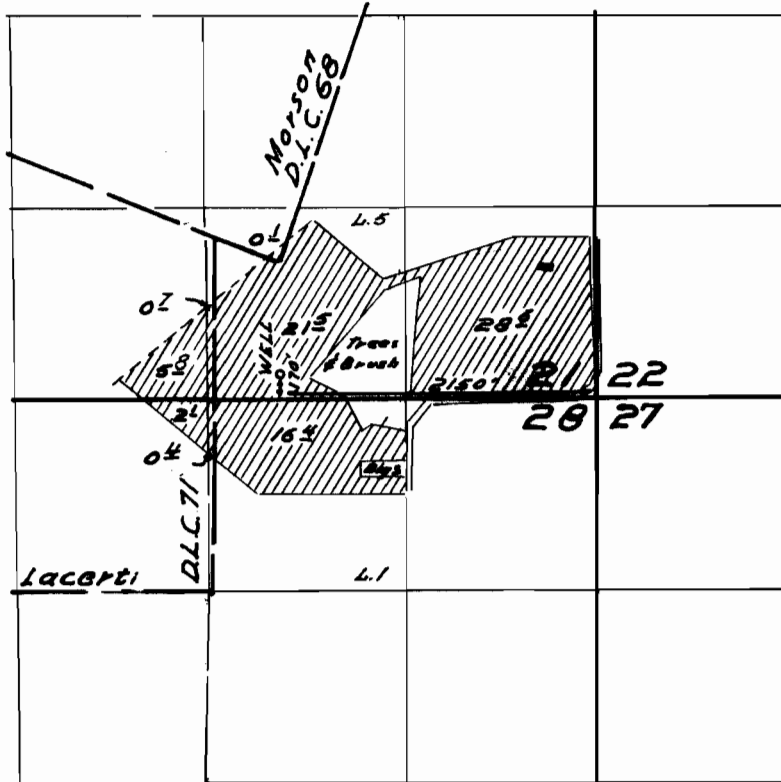

## FINAL PROOF SURVEY UNDER

Application No. G-2510 Permit No. G-2319  
IN NAME OF

Arlo Pugh

Surveyed Aug 19 1966, by N.J. Ruppert