

CEW 1/64

CSN 1/64

CSN 1/64

NE COR OF THE
S 1/2, N 1/2, SE
1/4, NW 1/4
(CNSN 1/256)

CSN 1/64

C 1/4,
SECTION 10

RECEIVED
AUG 27 2003
WATER RESOURCES DEPT.
SALEM, OREGON


SCALE: 1" = 100'

LOCATED IN THE SOUTHEAST ONE-QUARTER OF THE
NORTHWEST ONE-QUARTER OF
SECTION 10, TOWNSHIP 13, RANGE 9 EAST, W.M.,
JEFFERSON COUNTY, OREGON
PERMIT NO. G12627

1.3 ACRES OF WATER RIGHT

I, WILLIAM R. TYE, CERTIFIED WATER RIGHT EXAMINER IN THE STATE OF OREGON, HEREBY CERTIFY THE FINAL PROOF MAP WAS PREPARED UNDER MY DIRECT SUPERVISION.

THE PREPARATION OF THIS MAP IS FOR THE PURPOSE OF IDENTIFYING THE LOCATION OF THE WATER RIGHT ONLY AND HAS NO INTENT TO PROVIDE DIMENSIONS OR LOCATIONS OF PROPERTY OWNERSHIP LINES.

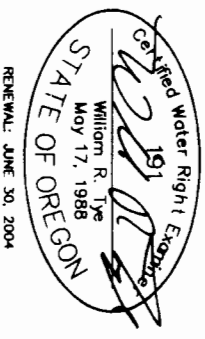

TITLE: WATER RIGHTS
JOB NO: 674
SCALE: 1" = 100' DRAWN BY: A.