


T.17S.R.22E.W.M.

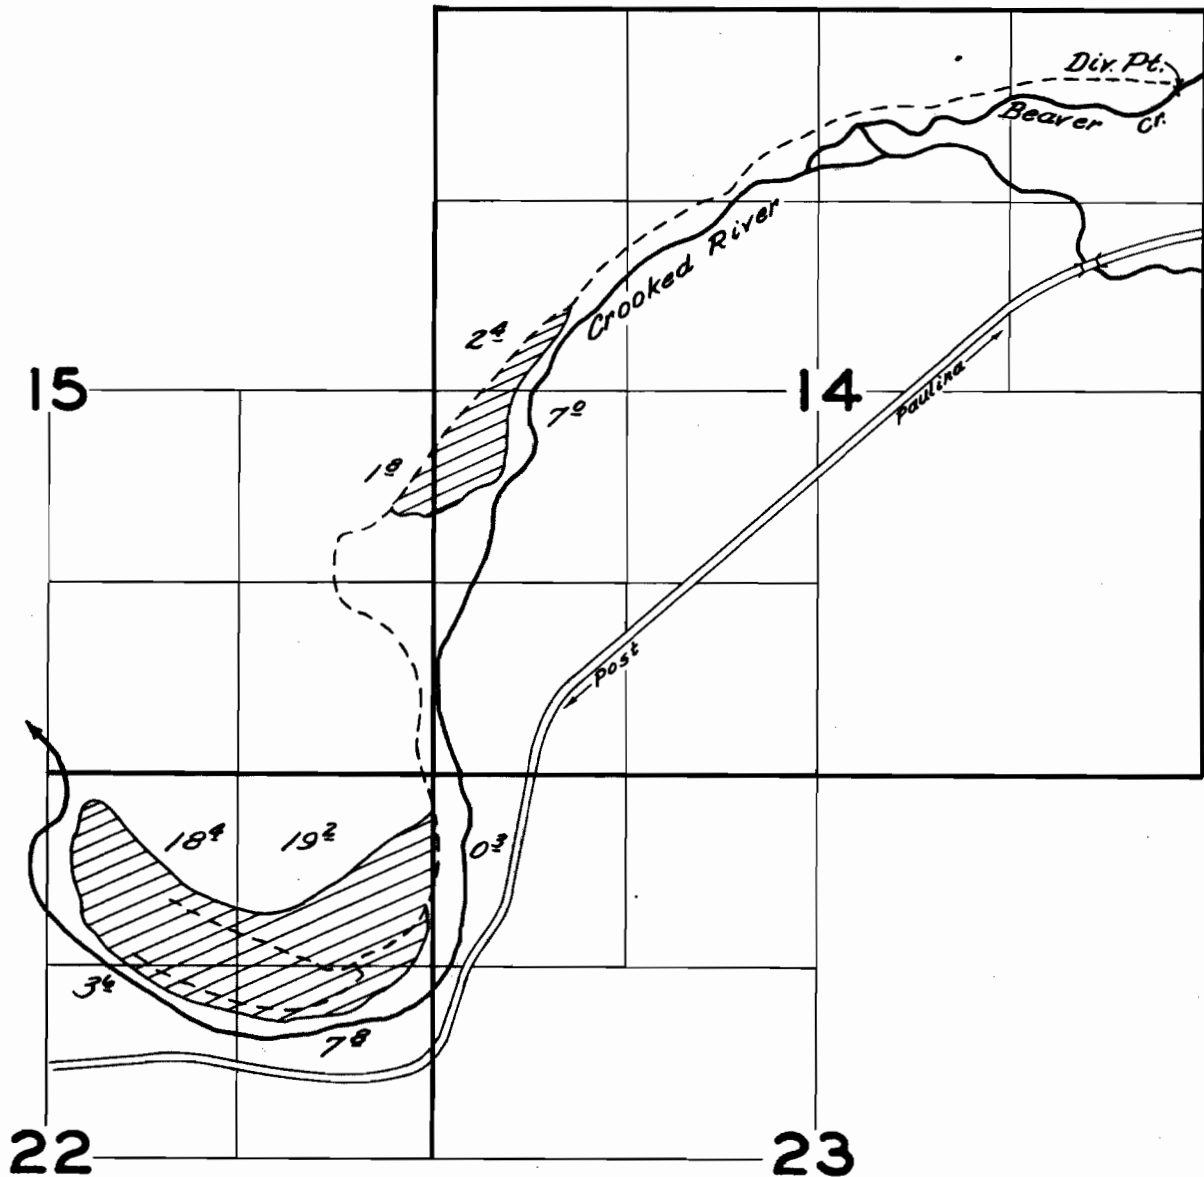

**FINAL PROOF SURVEY**  
UNDER

Application No. 17246 Permit No. 12966  
IN NAME OF

H. F. Severance

Surveyed Sept. 25 1957, by C. O. Buntala