

Lands irrigated under Certificate #67641 to remain in place.



Lands by right





Lands owned by Robert O. Carver irrigated by rights from Certificate #67641.



Lands by right



NOTE: The preparation of this map was for the purpose of identifying the location of the proposed water right and has no intent to provide dimensions or location of property ownership lines. Location information shown hereon was furnished by the applicant.

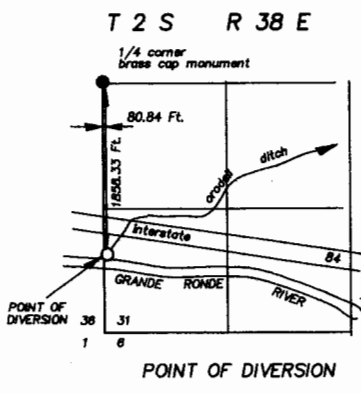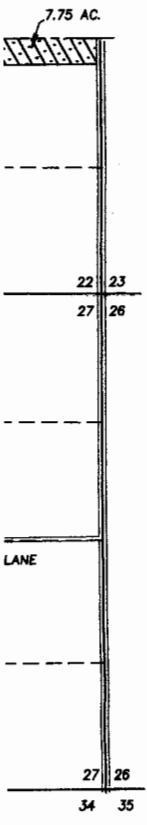

SCALE 1" = 1320'

by Rick and Janice Ewing Irrigated
m Certificate #67641

by Robert L. Brooks Irrigated
m Certificate #67641.

**FINAL PROOF MAP OF
CHANGE IN PLACE OF USE
AND POINT OF DIVERSION**

FOR
JACQUETTA L. ZURBRICK
BY

BAGETT- GRIFFITH & BLACKMAN
2006 ADAMS AVENUE
LAGRANDE, ORE. 97850
September 17, 2003

APPLICATION NO. T-8382

PERMIT NUMBER T-8382

RECEIVED
OCT 06 2003