


U 448

36073
80623

T.26S.R.14E.W.M.

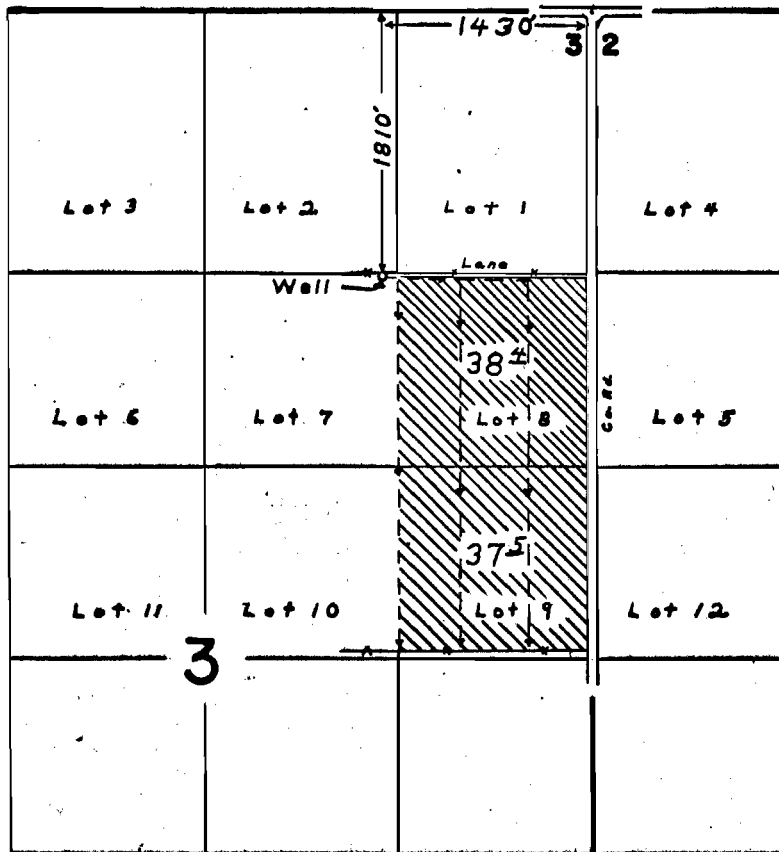

FINAL PROOF SURVEY UNDER

Application No. U-467 Permit No. U-448
IN NAME OF

FLOYD and VENITA BRANCH

Surveyed AUG. 3. 1968, by L. E. GOULD