


G-5532
47717
T9213
80624
T920

T.26S. R.14E., W.M.

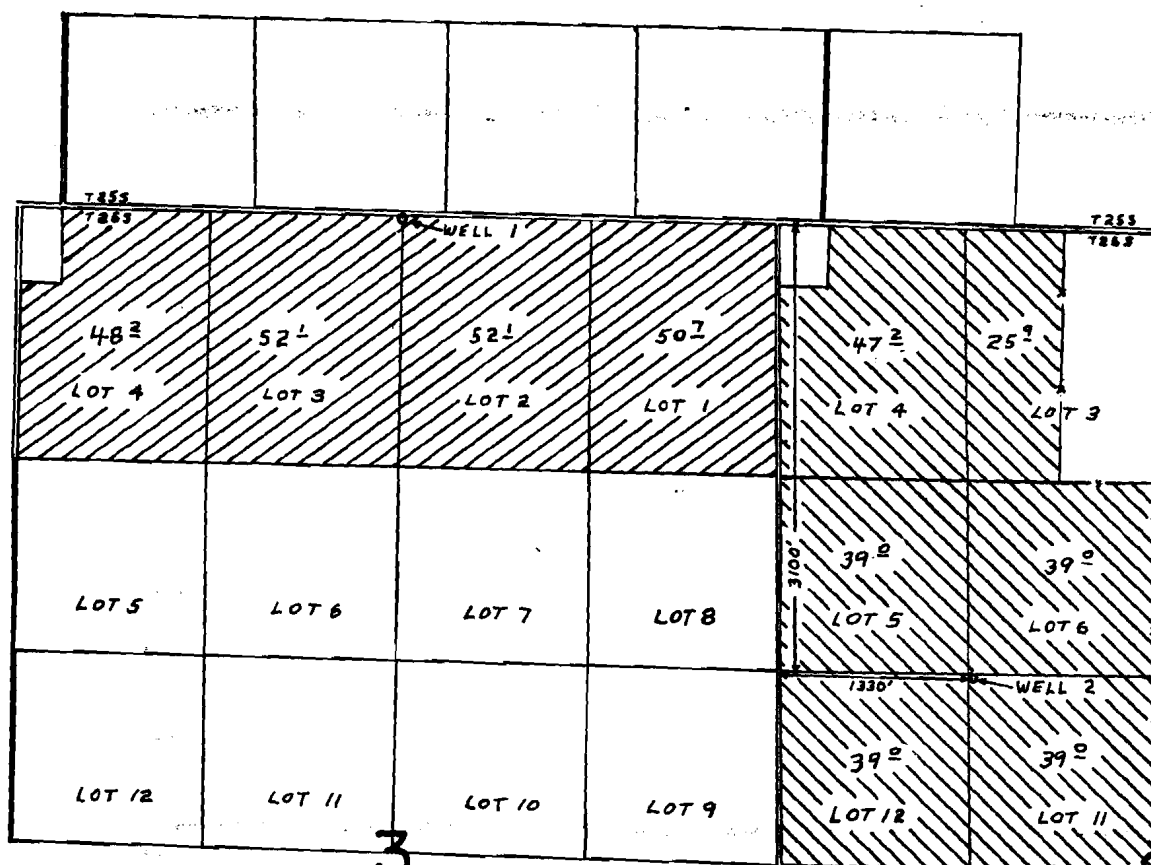

WELL 1 LOC. 2590' W. & 30' S. FROM N.E. COR. SEC. 3

WELL 1
WELL 2



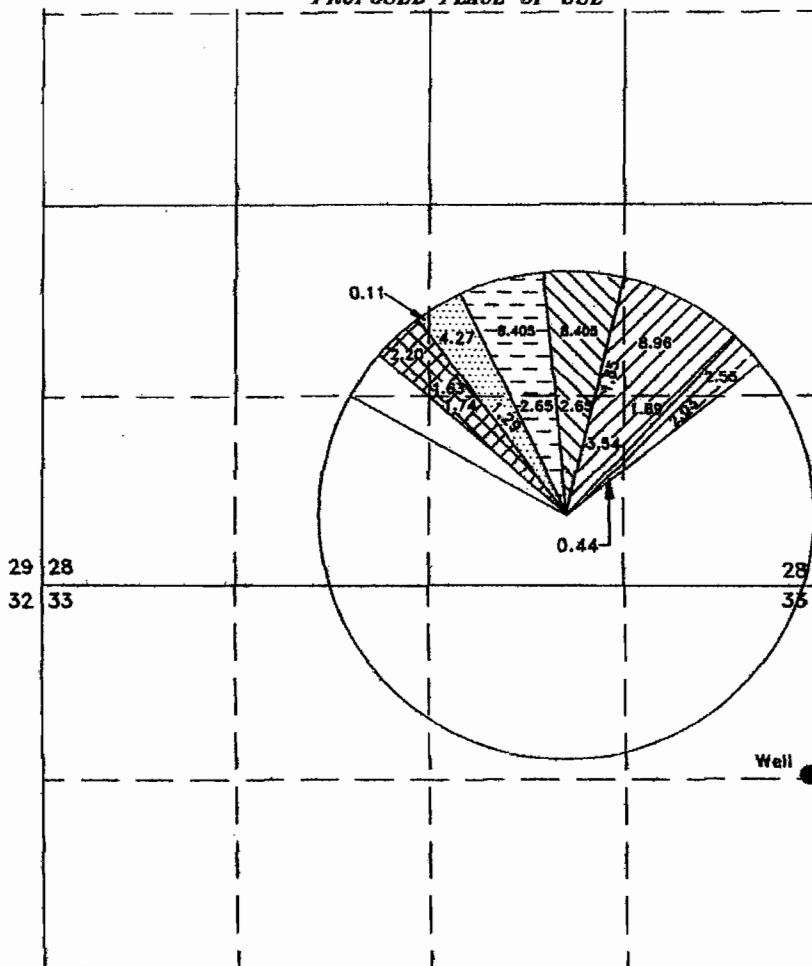
FINAL PROOF SURVEY UNDER

Application No. G-5736.. Permit No. G-5532..
IN NAME OF

ROY B. BOWERS & SONS, INC.

Surveyed JUL 16, 1977, by D.M. NORBY

CHS-1KK-155 1 1977-A

 PROPOSED PLACE OF USE[illegible]

Certified Water Right Examining
9127
Carl E. Sundet
STATE OF OREGON
Carl E. Sundet
Nov. 19, 1987
renewed 6-30-04

T-9213



SCALE

1" = 1320'



**ADDITIONAL MAP
TO ACCOMPANY APPLICATION FOR A
WATER RIGHT TRANSFER**

Lake County, Oregon
Kenneth & Kathleen Kruse
Kruse Ranch LLC


Sections 2 & 3, T.26S. R.14E., W.M.

Tax Lots 301 & 500


Authorized Place of Use

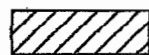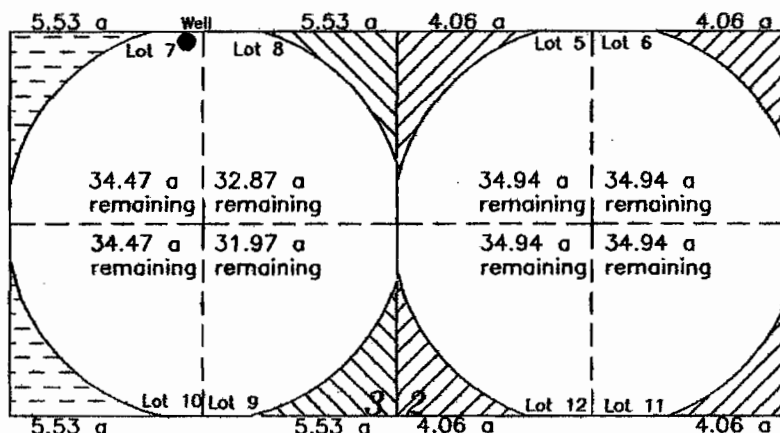

16.24 a to transfer from
P G-5532 C #47717

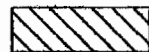

11.06 a to transfer from
P U-448 C #36073

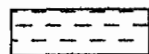



11.06 a to transfer from
P G-5499 C #48031

Authorized point of appropriation is
1810' S & 1430' W of the NE
Section Corner Section 3

Section 13, T.26S. R.14E., W.M.

Tax Lot 1000

Authorized Place of Use

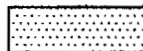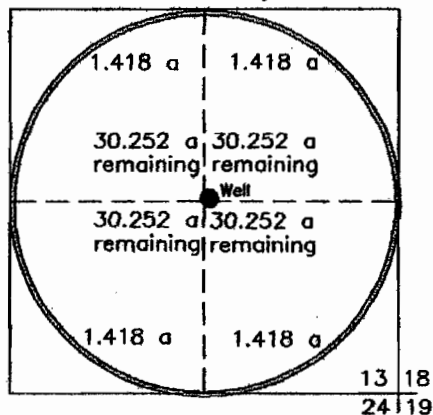

5.67 a to transfer from
P G-7361 C #76571

Authorized point of appropriation is
1330' N & 1310' W of the SE
Section Corner Section 13

Prepared by: Sundet & Associates
P.O. Box 1228
Lakeview, OR 97630
541-947-3293

Drawing #14802

This map is for the purpose of identifying the location
of the water right only and is not intended to provide
legal dimensions or location of property ownership lines.

RECEIVED

AUG 22 2002

WATER RESOURCES DEPT.
SALEM, OREGON




Revised 6-30-04

T-9213

**ADDITIONAL MAP
TO ACCOMPANY APPLICATION FOR A
WATER RIGHT TRANSFER
Sections 1 & 12, T.26S. R.14E., W.M.**


*Lake County, Oregon
Tax Lots 100 & 900
Kenneth & Kathleen Kruse
Kruse Ranch LLC*

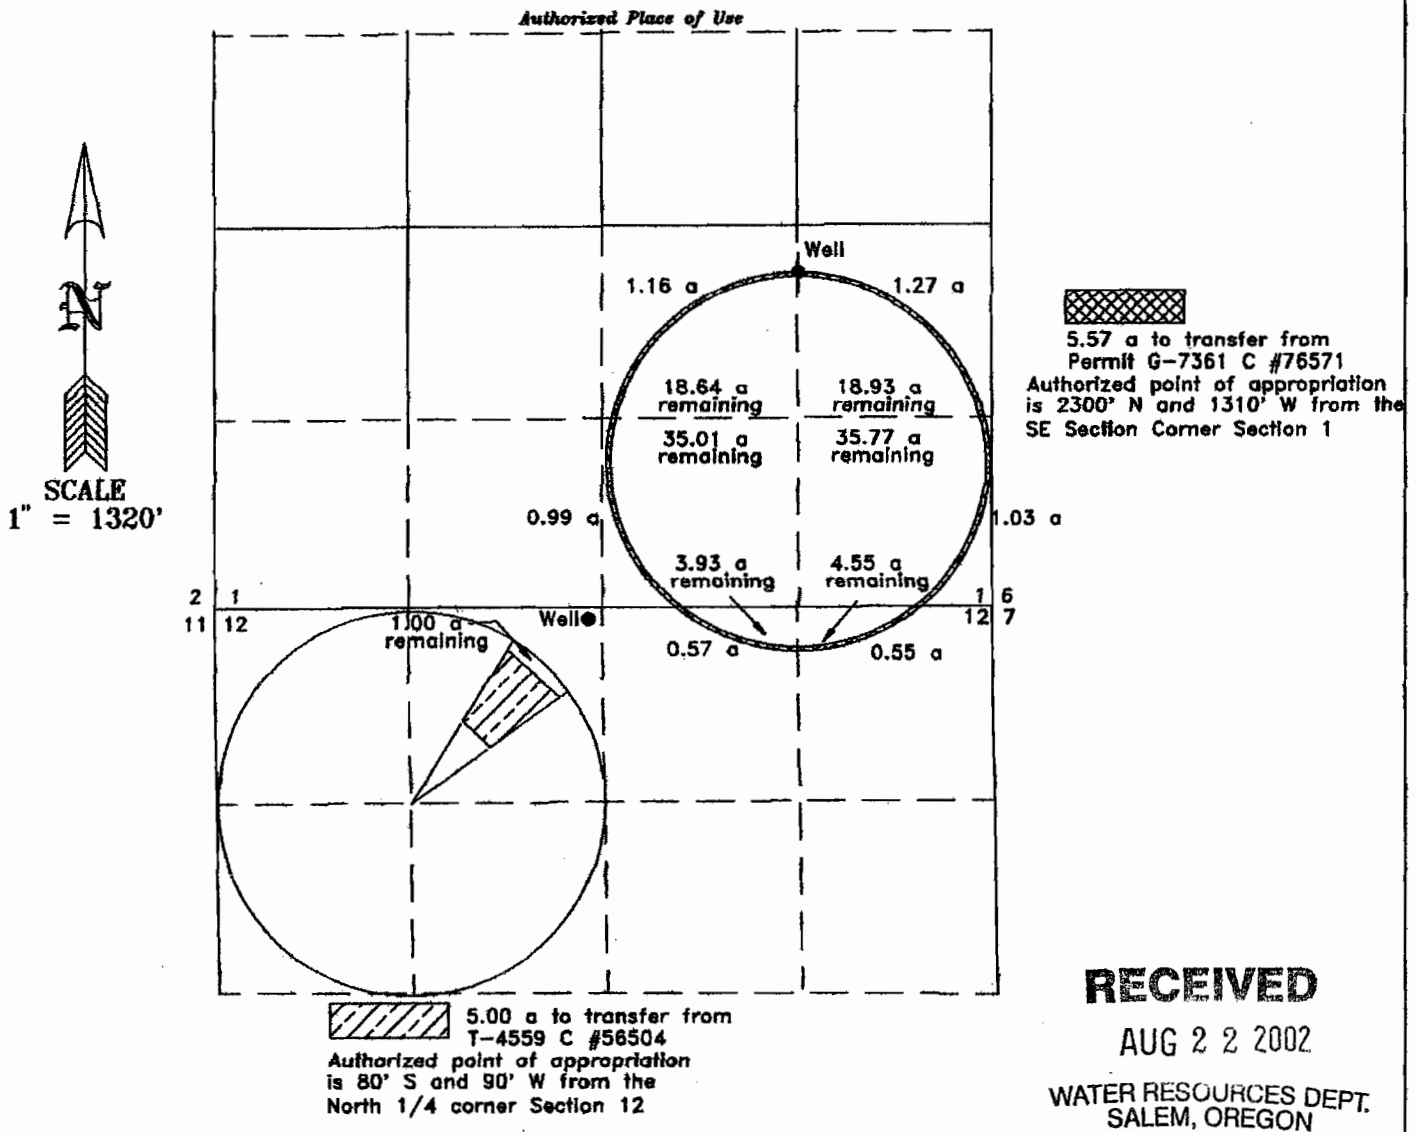

Prepared by: Sundet & Associates
P.O. Box 1228
Lakeview, OR 97630
541-947-3293

DR #15102

This map is for the purpose of identifying the location of the water right only and is not intended to provide legal dimensions or location of property ownership lines.

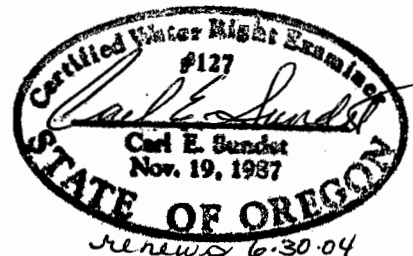

T-9213