




G-5499  
 48031  
 T9013  
 80625  
 T9013

T.26S.R.14E.W.M.

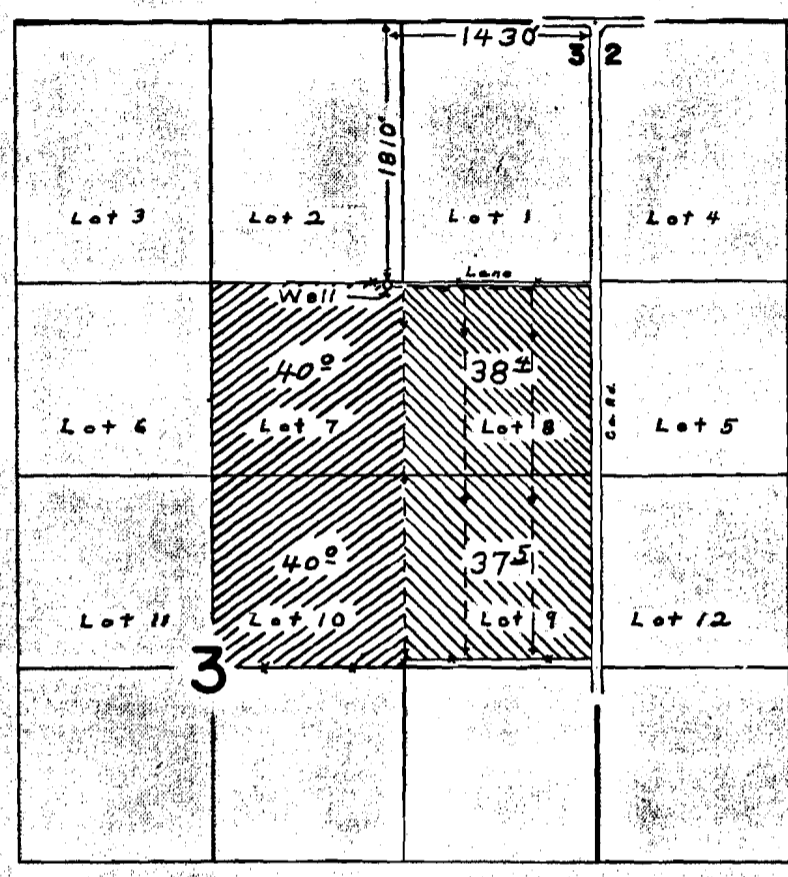

-  APP'L. U-467
-  APP'L. G-5685

**FINAL PROOF SURVEY**  
 UNDER

Application No. G-5685 Permit No. G-5499  
U-467 U-448  
 IN NAME OF

FLOYD and VENITA BRANCH

Surveyed AUG. 3, 1968, by L. E. GOULD  
JUL. 15, 1977 D. M. NORBY