G-5499
48031
T9213

80625
T9213

T.26S.R.14E.W.M.

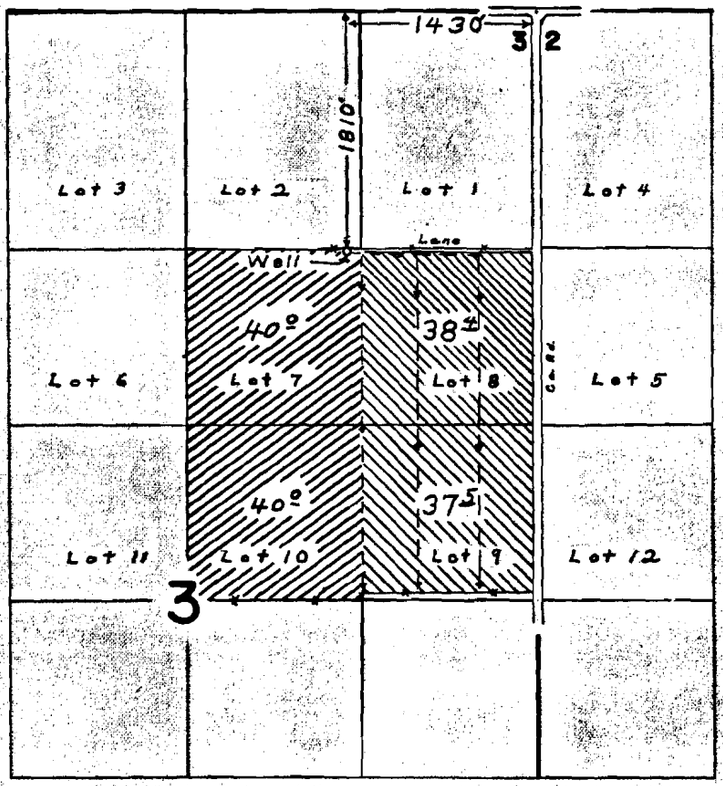

FINAL PROOF SURVEY

UNDER

G-5685 G-5499

Application No. U-467 Permit No. U-448

IN NAME OF

FLOYD and VENITA BRANCH

Surveyed AUG. 3 1968, by L. E. GOULD

JUL. 15 1977 D. M. NORBY

CHR-1RR-155 1968-U

ADDITIONAL MAP
TO ACCOMPANY APPLICATION FOR A
WATER RIGHT TRANSFER
Sections 28 & 33, T.25S. R.14E., W.M.

Lake County, Oregon
Tax Lot 104
KENNETH & KATHLEEN KRUSE
KRUSE RANCH, LLC

PROPOSED PLACE OF USE

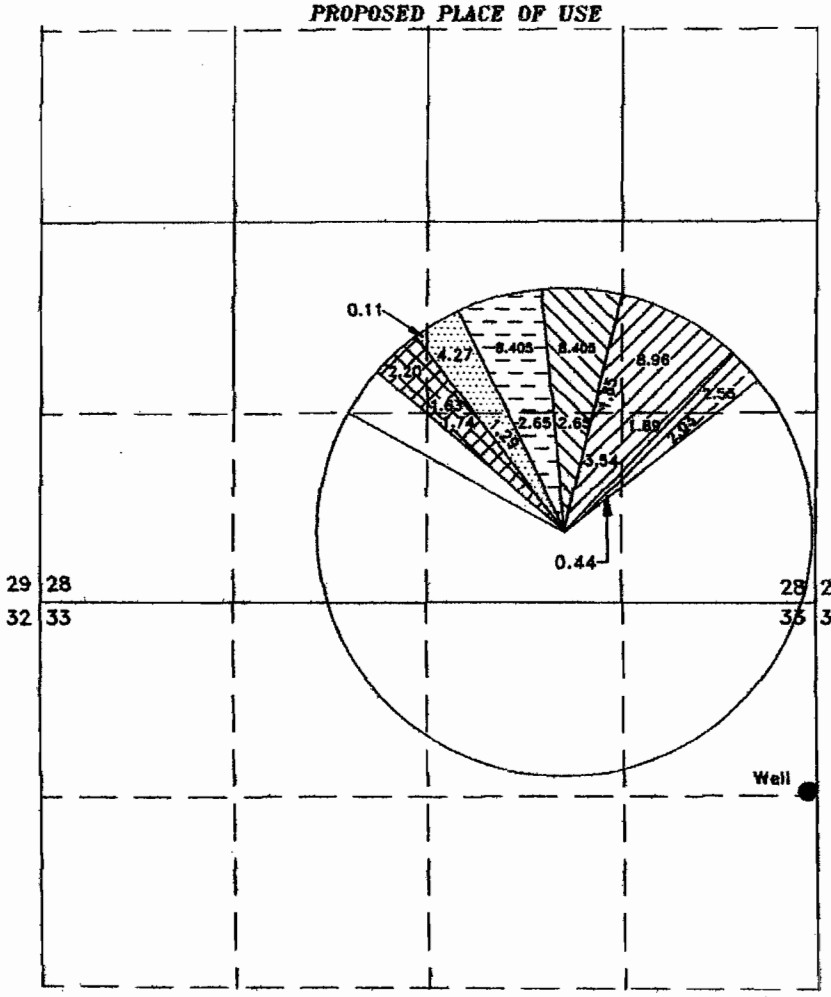

5.00 a transfered from T-4559 C #56504

16.24 a transfered from P G-5532 C #47717

11.06 a transfered from P U-448 C #36073

11.06 a transfered from P G-5499 C #48031

5.67 a transfered from P G-7361 C #76571

5.57 a transfered from P G-7361 C #76571

Proposed point of appropriation is 1310' S and 40' W of the NE Section Corner Section 33

RECEIVED
AUG 2 2 2002
WATER RESOURCES DEPT.
SALEM, OREGON

Prepared by: Sundet & Associates
P.O. Box 1228
Lakeview, OR 97630
541-947-3293

DR #15002

Certified Water Right Examiner #127
Carl E. Sundet
Nov. 19, 1987
STATE OF OREGON
renewed 6-30-04

This map is for the purpose of identifying the location of the water right only and is not intended to provide legal dimensions or location of property ownership lines.

T-9213

ADDITIONAL MAP
TO ACCOMPANY APPLICATION FOR A
WATER RIGHT TRANSFER

Lake County, Oregon

Kenneth & Kathleen Kruse

Kruse Ranch LLC

N

SCALE
1" = 1320'

Sections 2 & 3, T.26S. R.14E., W.M.

Tax Lots 301 & 500

Authorized Place of Use

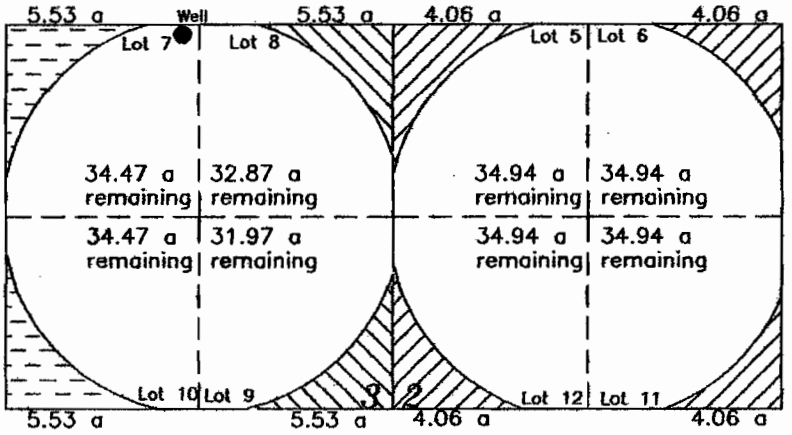

16.24 a to transfer from P G-5532 C #47717

11.06 a to transfer from P U-448 C #36073

11.06 a to transfer from P G-5499 C #48031

Authorized point of appropriation is 1810' S & 1430' W of the NE Section Corner Section 3

Section 13, T.26S. R.14E., W.M.

Tax Lot 1000

Authorized Place of Use

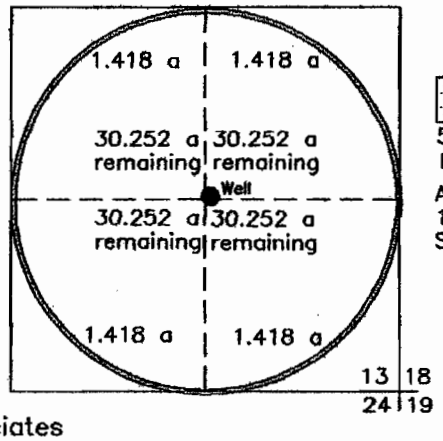

5.67 a to transfer from P G-7361 C #76571

Authorized point of appropriation is 1330' N & 1310' W of the SE Section Corner Section 13

Prepared by: Sundet & Associates
P.O. Box 1228
Lakeview, OR 97630
541-947-3293

Drawing #14802

This map is for the purpose of identifying the location of the water right only and is not intended to provide legal dimensions or location of property ownership lines.

RECEIVED
AUG 2 2 2002
WATER RESOURCES DEPT.
SALEM, OREGON

Certified Water Right Examiner
#127
Carl E. Sundet
Carl E. Sundet
Nov. 19, 1987
STATE OF OREGON

Renews 6-30-04

T-9213

ADDITIONAL MAP
TO ACCOMPANY APPLICATION FOR A
WATER RIGHT TRANSFER
Sections 1 & 12, T.26S. R.14E., W.M.

Lake County, Oregon
Tax Lots 100 & 900
Kenneth & Kathleen Kruse
Kruse Ranch LLC

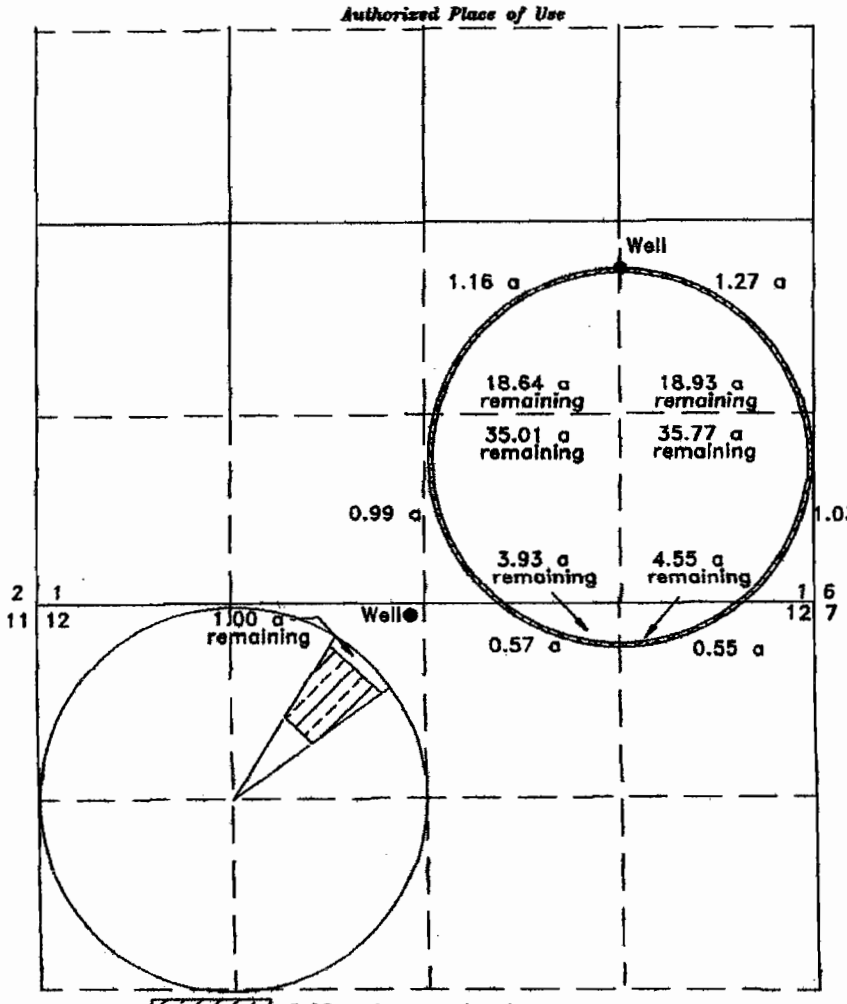

5.57 a to transfer from Permit G-7361 C #76571
Authorized point of appropriation is 2300' N and 1310' W from the SE Section Corner Section 1

RECEIVED
AUG 2 2 2002
WATER RESOURCES DEPT.
SALEM, OREGON

Prepared by: Sundet & Associates
P.O. Box 1228
Lakeview, OR 97630
541-947-3293

DR #15102

Certified Water Right Examiner #127
Carl E. Sundet
Nov. 19, 1987
STATE OF OREGON
renews 6-30-04

This map is for the purpose of identifying the location of the water right only and is not intended to provide legal dimensions or location of property ownership lines.

T-9213