
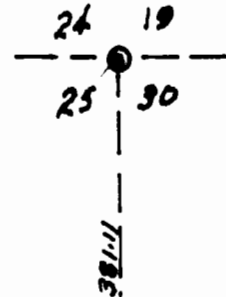


FINAL PROOF SURVEY


T.55. R.11W. *pc*

A SURVEY TO VERIFY APPLICANT HAS FULLY
COMPLIED WITH THE REQUIREMENTS OF APPLICATION
S-81970, PERMIT 52359 & APPLICATION R-81982,
PERMIT R-12424

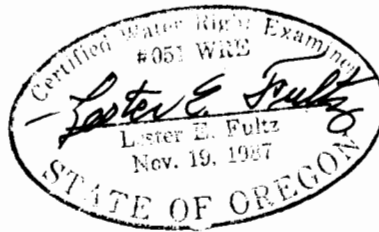

HIGHWAY 101

ICES DEPT
CON

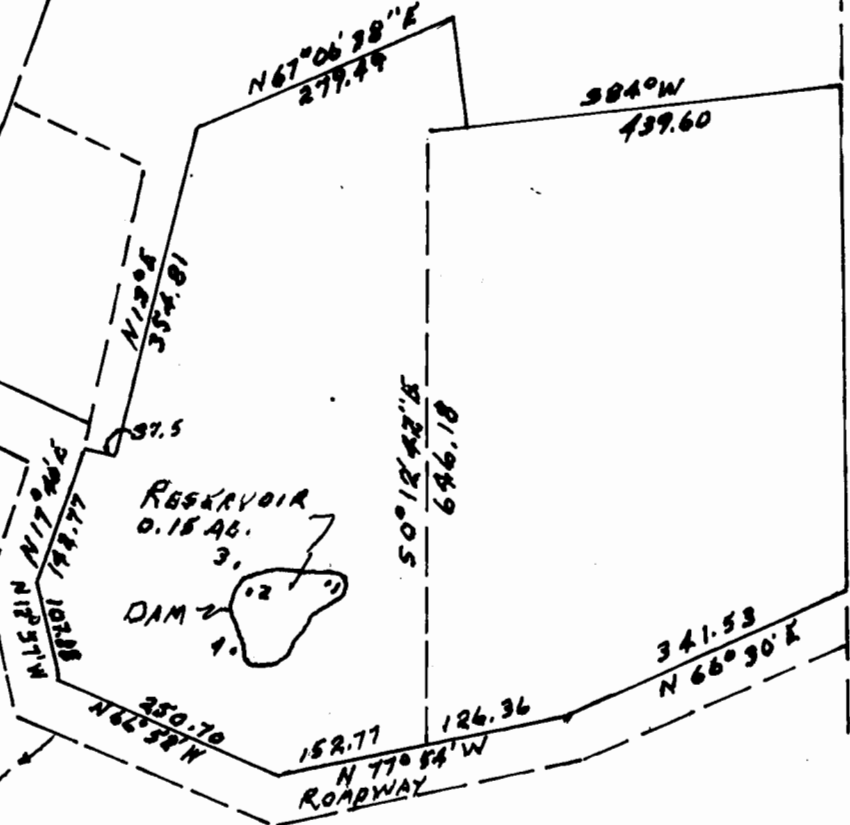

- BEARING & DISTANCE FROM N.E. CORNER OF SECTION 25:
1. POINT OF DIVERSION --- SOUTH 30° 40' WEST, 1,048.10 FEET,
 2. OVERFLOW --- SOUTH 34° 12' WEST, 1,093.85 FEET.
 3. NORTH DAM POINT --- SOUTH 35° 24' WEST, 1,080.44 FEET.
 4. SOUTH DAM POINT --- SOUTH 33° 03' WEST, 1,153.21 FEET.