
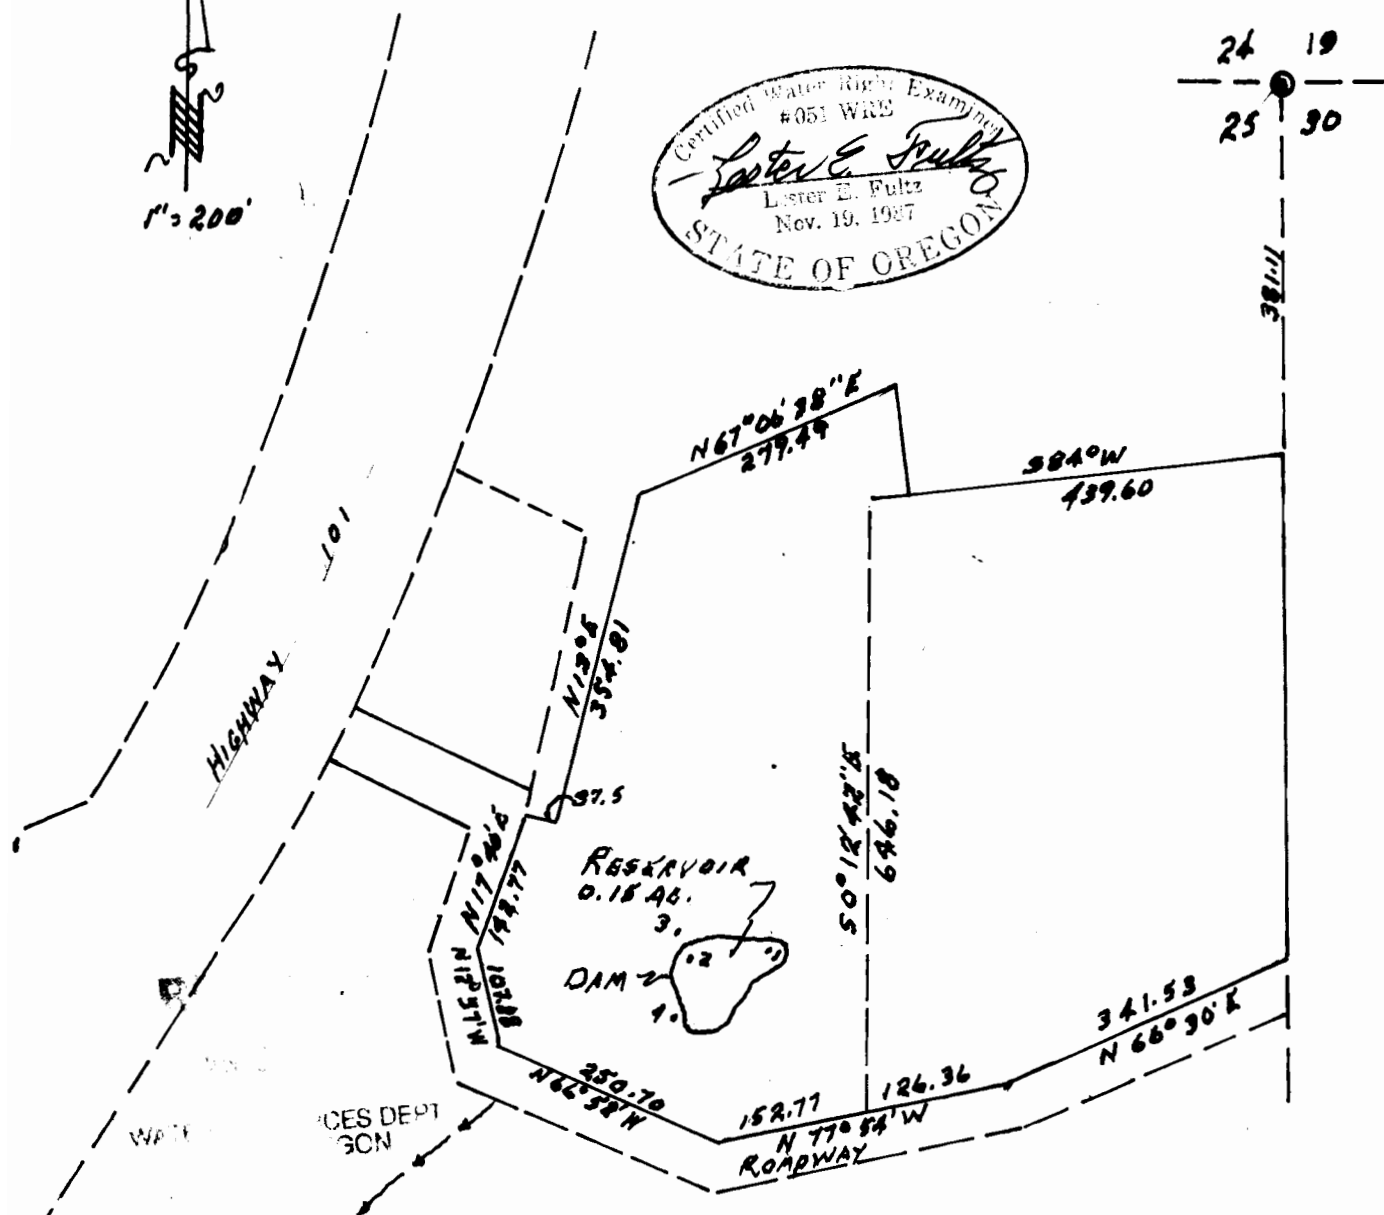


T.55. R.11W. *pc*

$r'' = 200'$

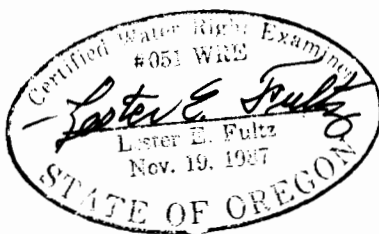

1. POINT OF DIVERSION --- SOUTH 30°40' WEST, 1,043.10 FEET.
2. OVERFLOW ----- SOUTH 34°12' WEST, 1,093.85 FEET.
3. NORTH DAM POINT --- SOUTH 35°24' WEST, 1,080.44 FEET.
4. SOUTH DAM POINT --- SOUTH 33°03' WEST, 1,153.21 FEET.