


# T.37S., R.11 1/2 E., W.M.

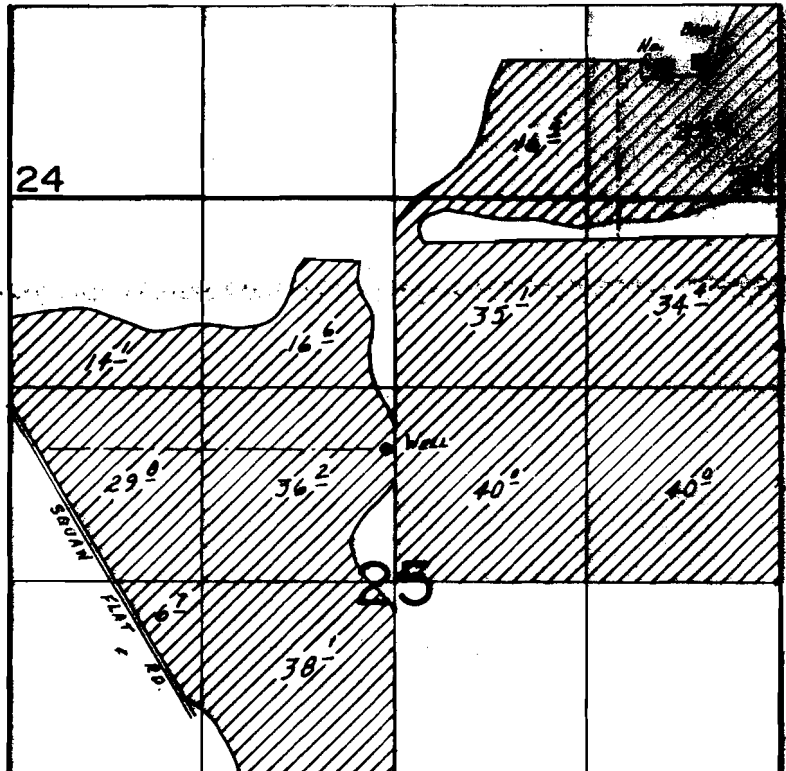

WELL LOC.: 900' N. & 50' W. FROM C. 1/4 COR. SEC. 25.

SCALE: 1" = 1320'

## FINAL PROOF SURVEY UNDER

Application No. G-9238. Permit No. G-8576...  
IN NAME OF

### JELD-WEN, INC.

Surveyed May 17, 1985, by DEL SPARKS