
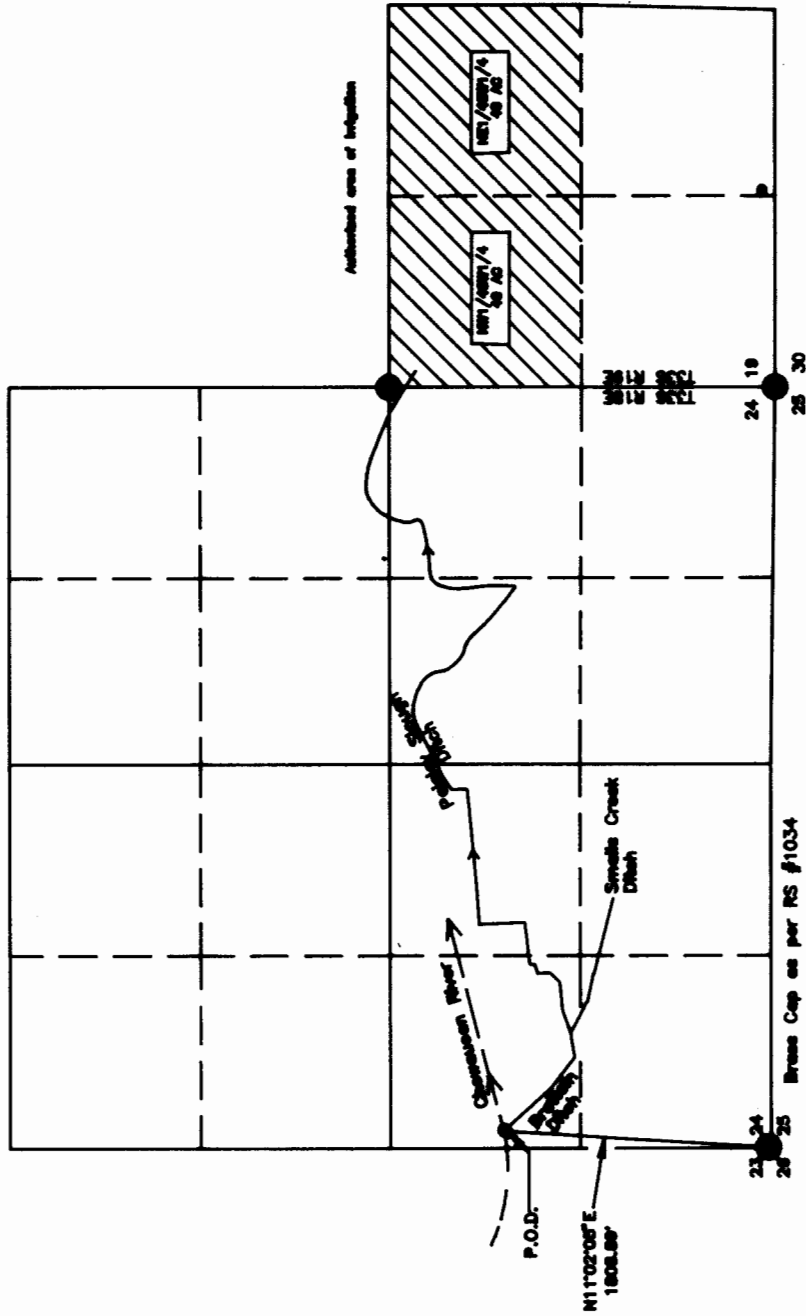


**AMENDED  
FINAL PROOF MAP  
Section 24, T.33S. R.18E., W.M.  
Lake County, Oregon  
Transfer T-8881**

**RECEIVED**

SEP 11 1997

WATER RESOURCES DEPT.  
SALEM, OREGON

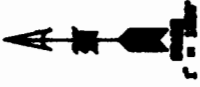

Survey for:  
Survey by:  
May 1987

Edmund Murphy  
Surveyor & Associates  
P.O. Box 1228  
Lebanon, OR 97030  
(503)947-3283  
Drawing #0187

This map is for the purpose of identifying the location of the water right only and is not intended to provide legal dimensions or location of property lines.