


T. 1N., R. 10E & 11E., W. 4M.

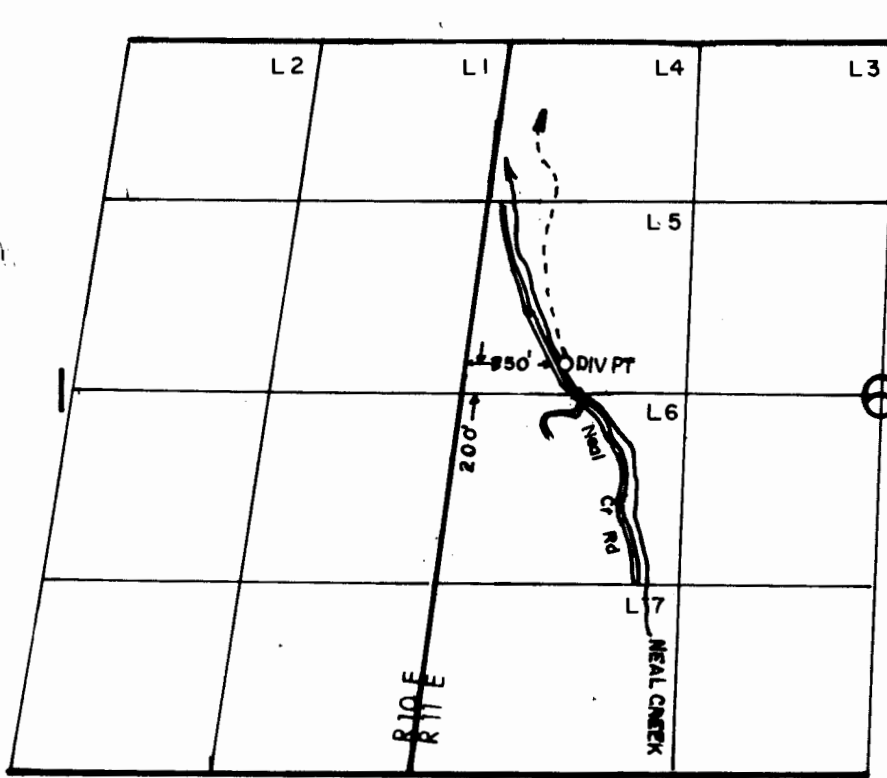

SCALE: 1" = 1320'

FINAL PROOF SURVEY UNDER

TRANSFER NO. 5886

Application No. Permit No.
IN NAME OF

.....TALLMAN.....ORCHARDS.....INC.....

Surveyed JULY..14. 1988., by Z. F. SALEH.....