


RANGE 32 EAST WILLAMETTE MERIDIAN

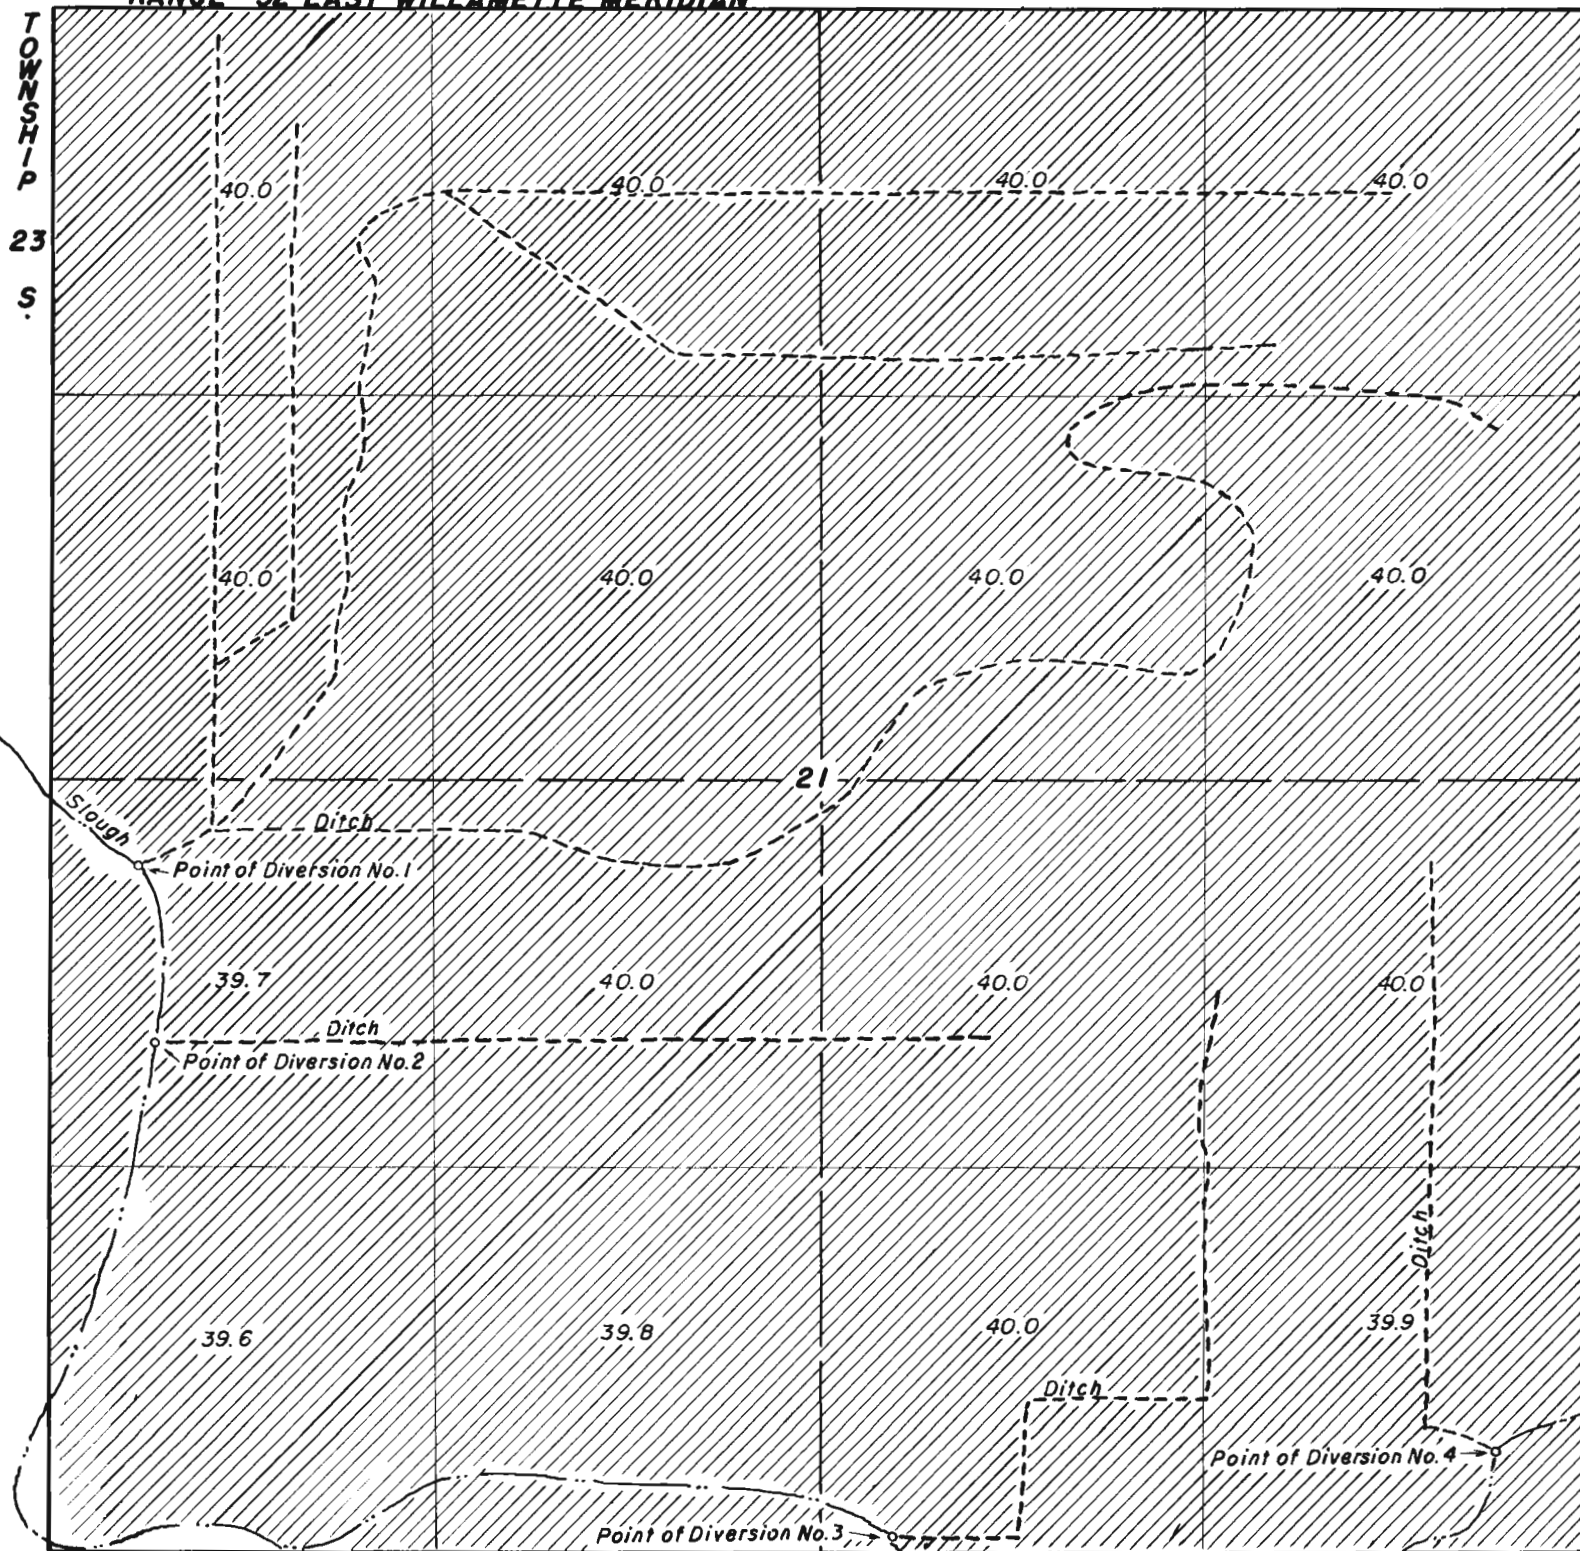

Scale: 8" = 1 Mile.

P. Tiller
Application No. ~~18773~~ 23813
Permit No. ~~23813~~ 18713

Survey for Final Project
by Paul Revis