


T. 28 S. R. 14 W.

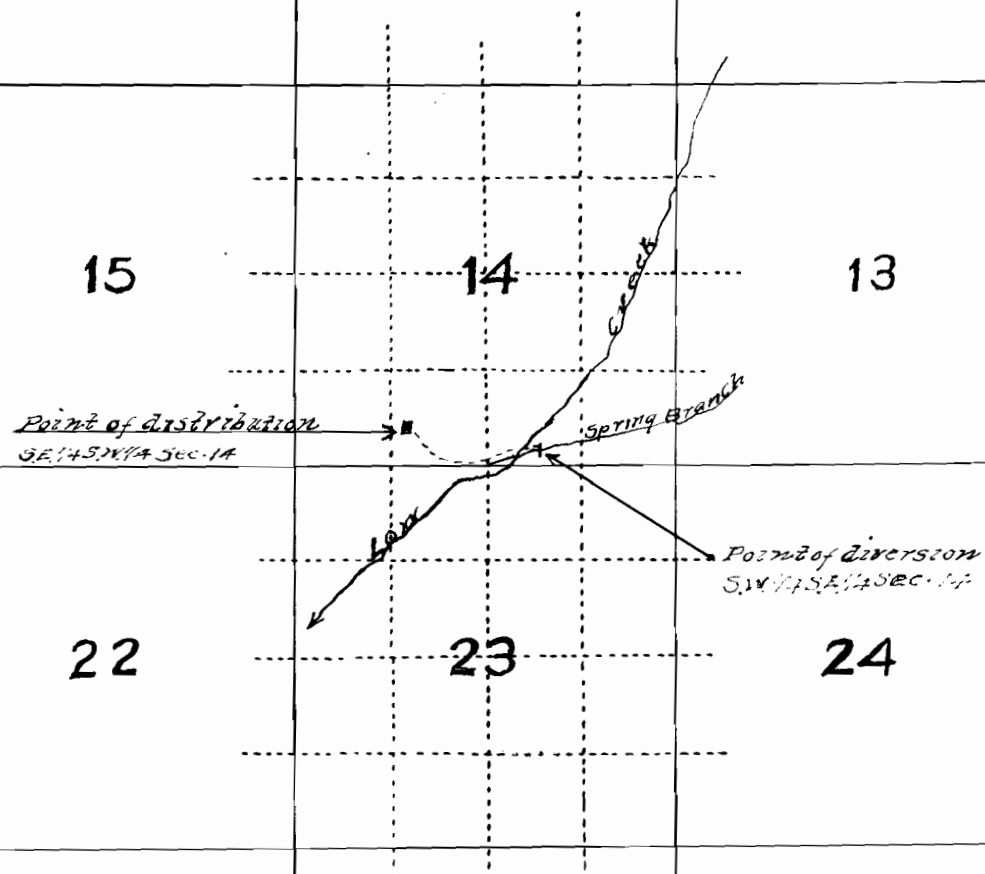

CERTIFICATE OF SURVEYOR

I, A. E. Hadsall, of Coos County, Oregon, do here by certify that this map was made from notes taken during an actual survey made by me on August 14, 1923, and it correctly represents the works described in the accompanying application, together with location of streams and other ditches in the immediate vicinity

A. E. Hadsall
Surveyor

9148
6011