


T. 4 S. R. 1 W., W.M.

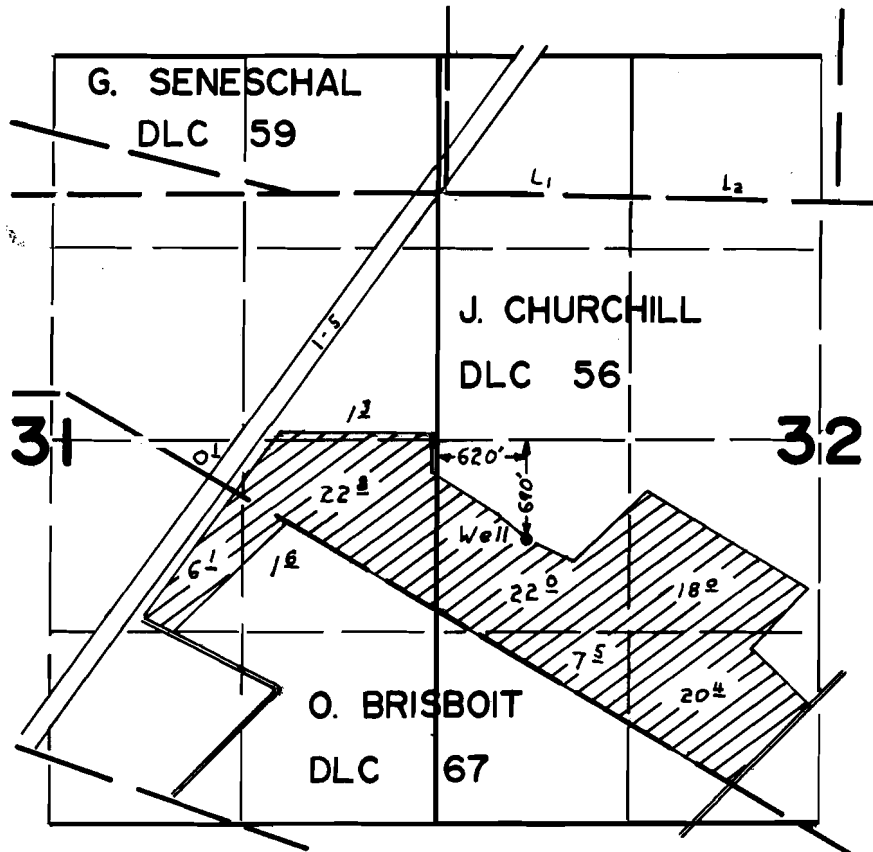

FINAL PROOF SURVEY UNDER

Application No. G-6754.. Permit No. G-6275..
IN NAME OF

.....LEONARD M. BIZON.....

Surveyed AUG. 17. 1977., by B. R. SUND.....