
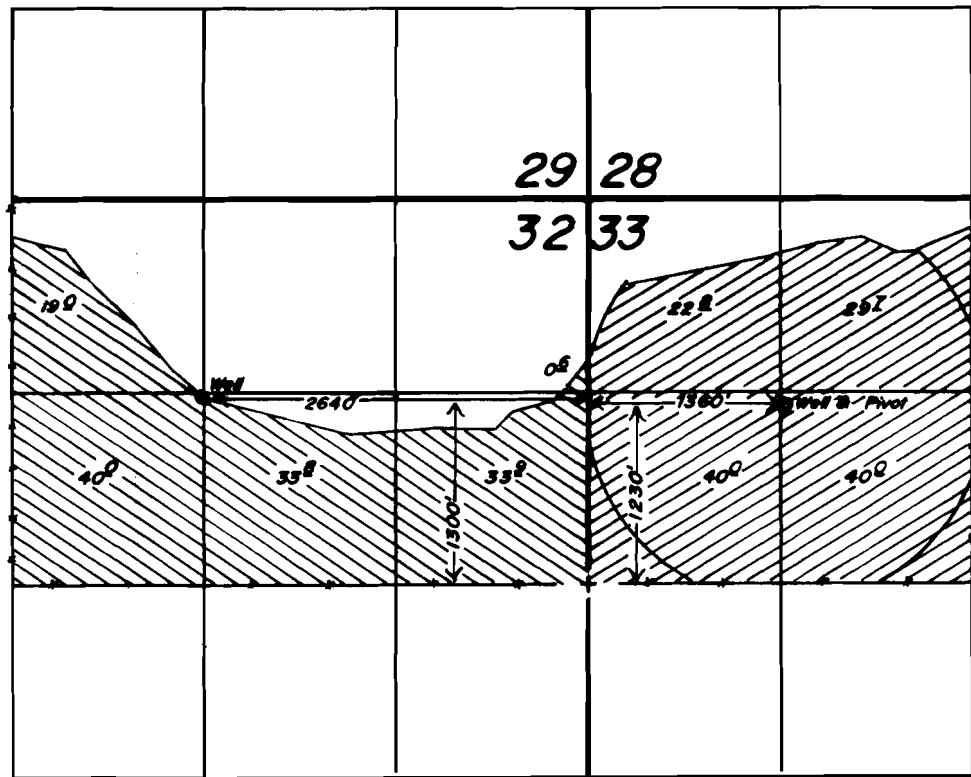


G-9063  
G-9067  
53349  
T9057  
80659  
T9057

# T. 26 S., R. 17 E., W. M.

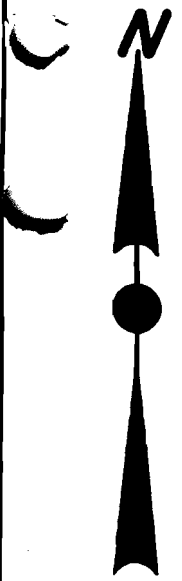

Scale: 1" = 1320'

## FINAL PROOF SURVEY UNDER

Application No. G-9822 Permit No. G-9067  
IN NAME OF

### GOLDEN RULE FARMS

Surveyed Oct. 22, 1984, by Leslie Olson