
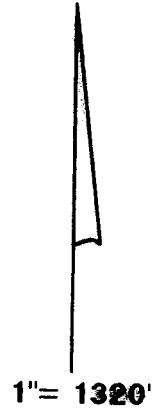


T.5S., R.1W., W.M.

RECEIVED

SEP 9 1993

WATER RESOURCES DEPT
SALEM, OREGON

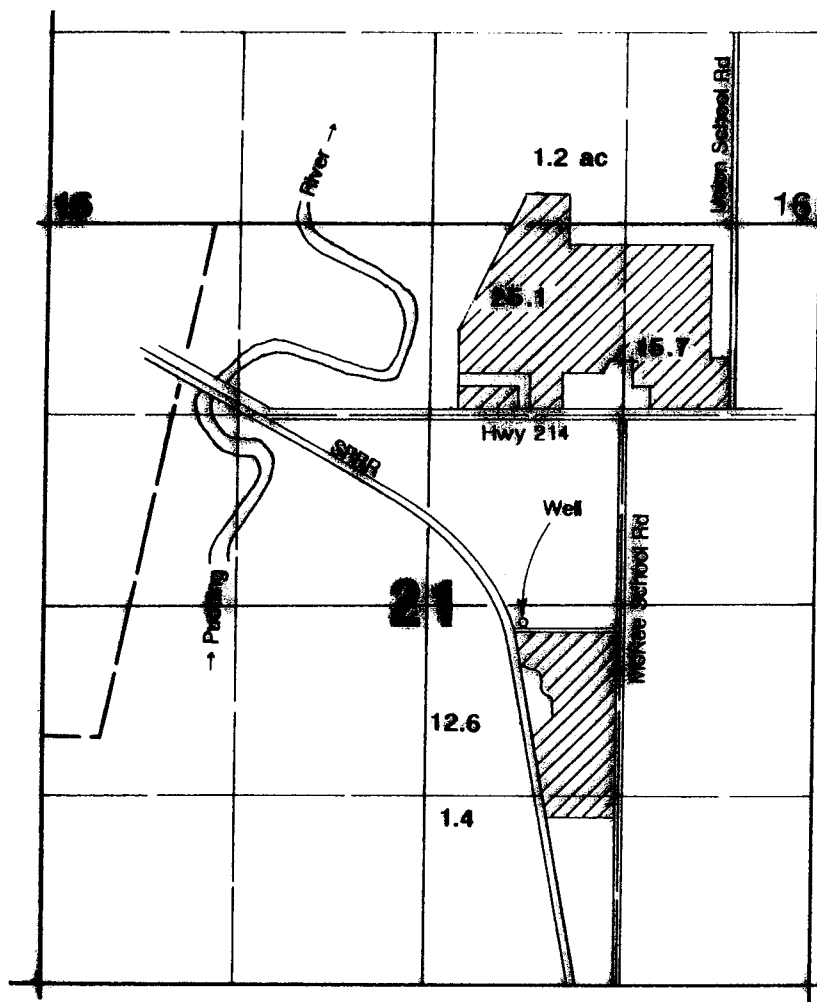


Area Irrigated

Well located 2500'N & 2000'W from SE corner Section 21.



Final Proof Survey

Application #: G-12183

Permit #: G-11404

In Name Of

Carl I. Vistica

Surveyed by Jim Schuette on August 16, 1993



T 7632