


CLAIM OF BENEFICIAL USE DIVERSION LOCATION MAP

For FILE NO. S-48301 – PERMIT NO. 36270

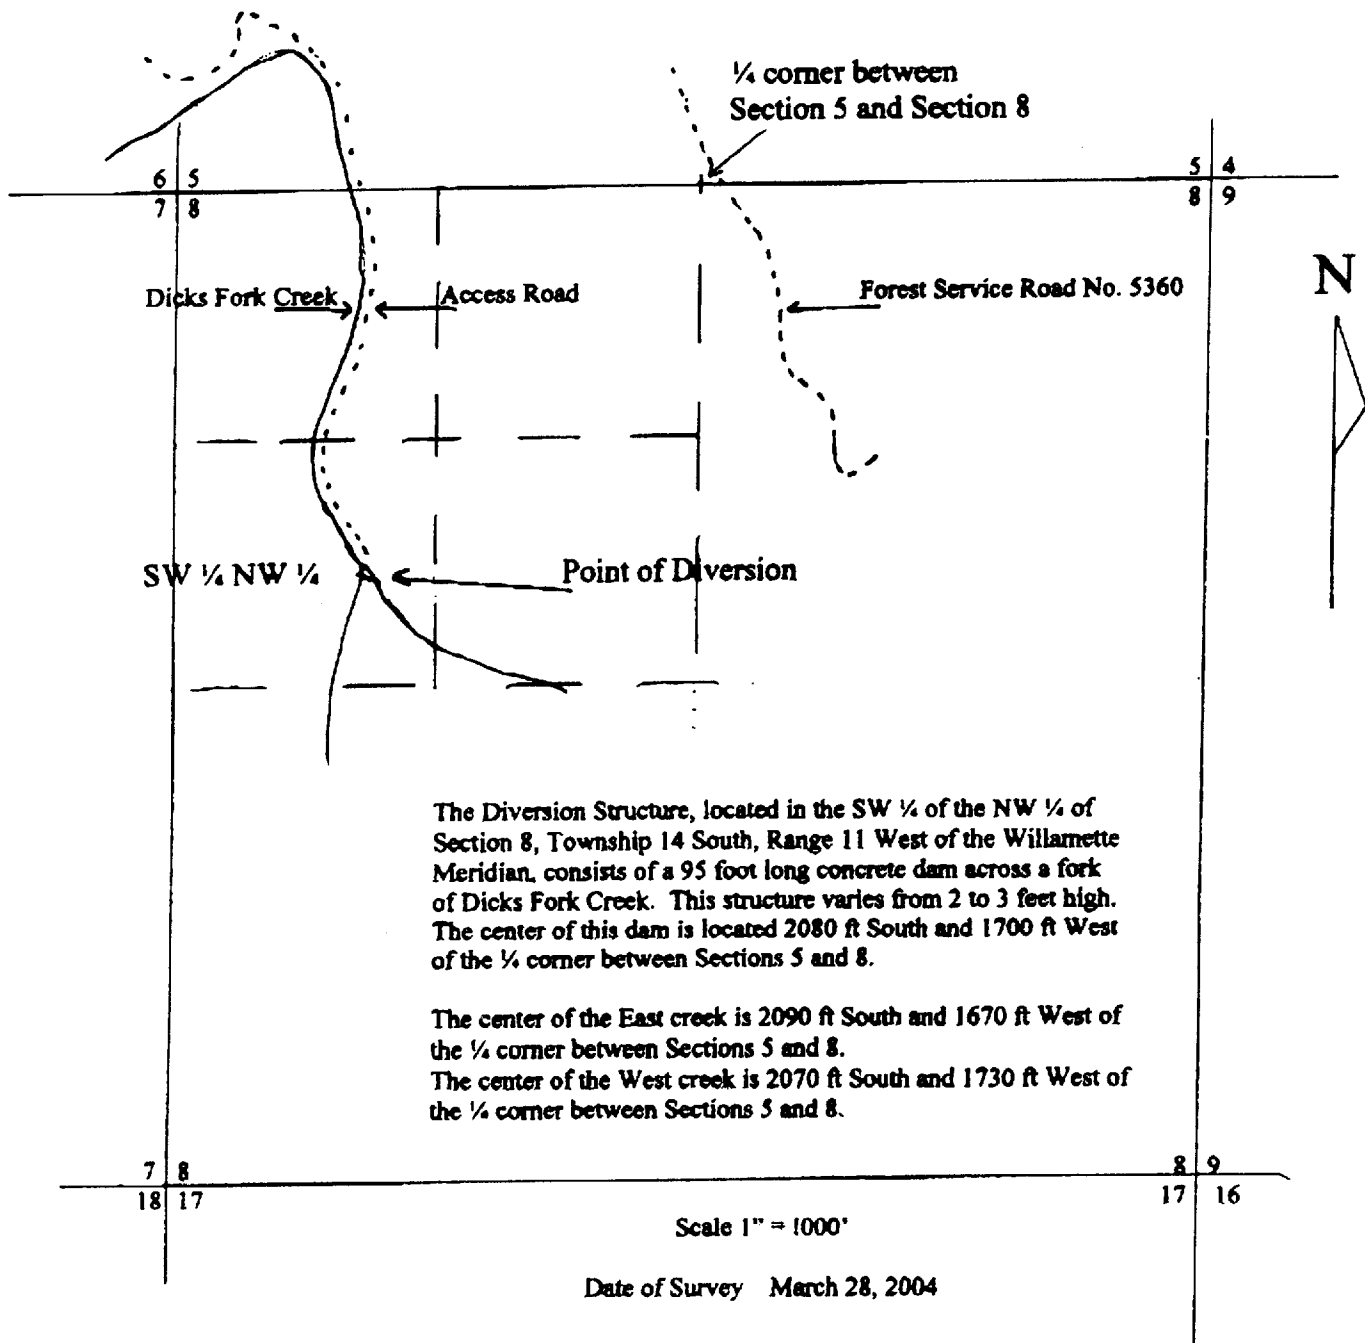

THIS MAP WAS PREPARED FOR THE PURPOSE OF IDENTIFYING THE LOCATION OF A WATER RIGHT DIVERSION POINT ONLY AND IS NOT INTENDED TO PROVIDE LEGAL DIMENSIONS OR LOCATION OF PROPERTY OWNERSHIP LINES.