


T.148.R.17E. W.1/4

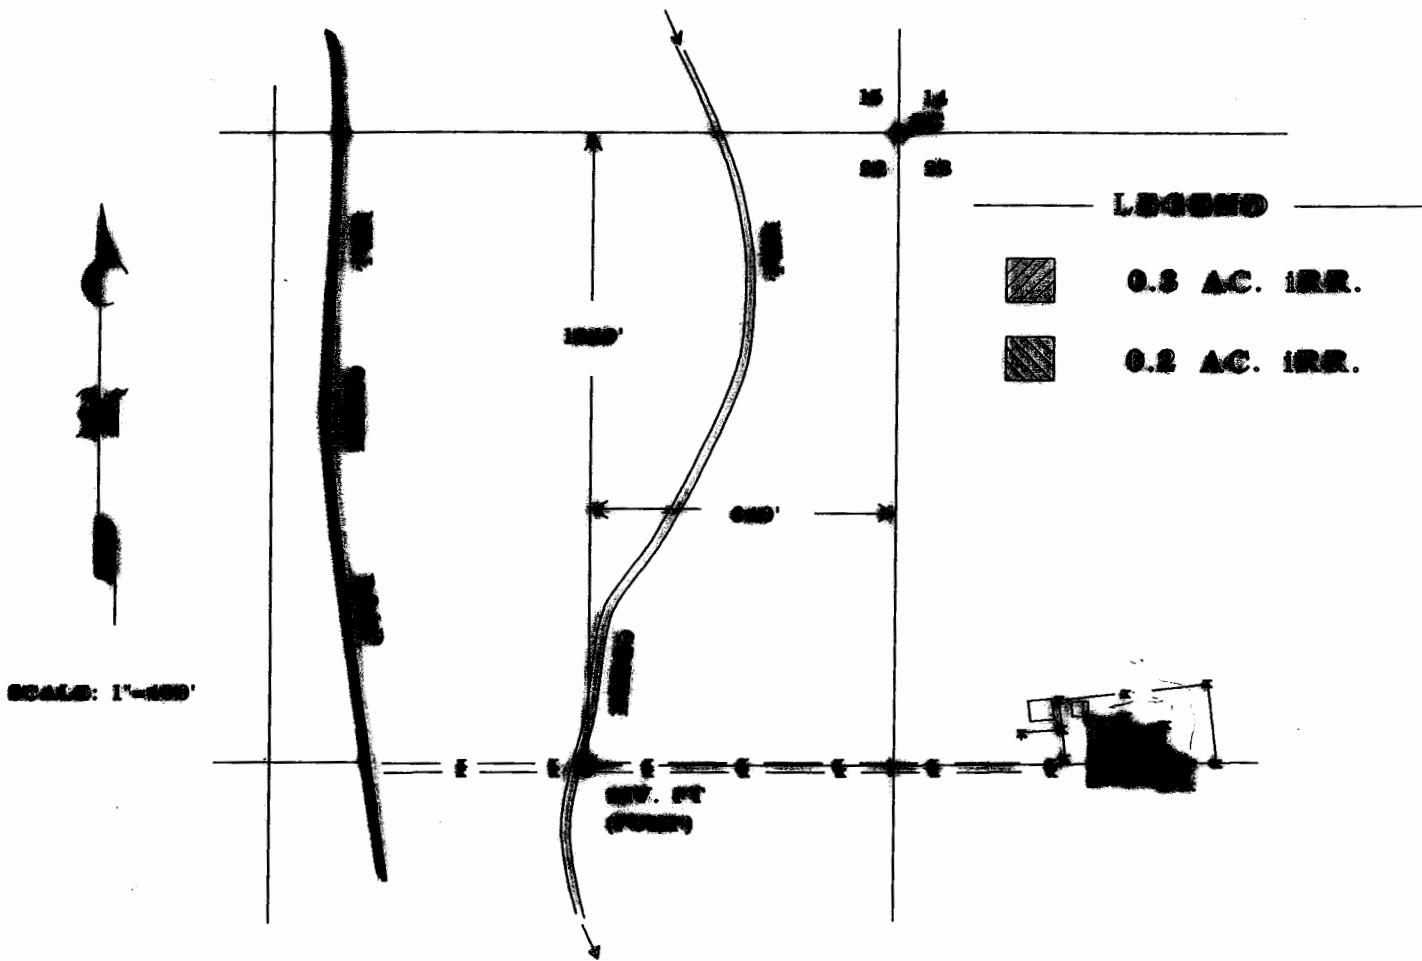

FINAL PROOF SURVEY

UNDER

TRANSFER NO. T-6664

IN THE NAME OF

ARLENE MATSON

Note: The preparation of this map was for the purpose of identifying the location of the proposed water right and has no intent to provide delineation or location of property surrounding same.

SURVEYED MARCH 28, 1993 BY

