G-9124
G56026
80684
T8883

T.26S., R.18E., W.M.

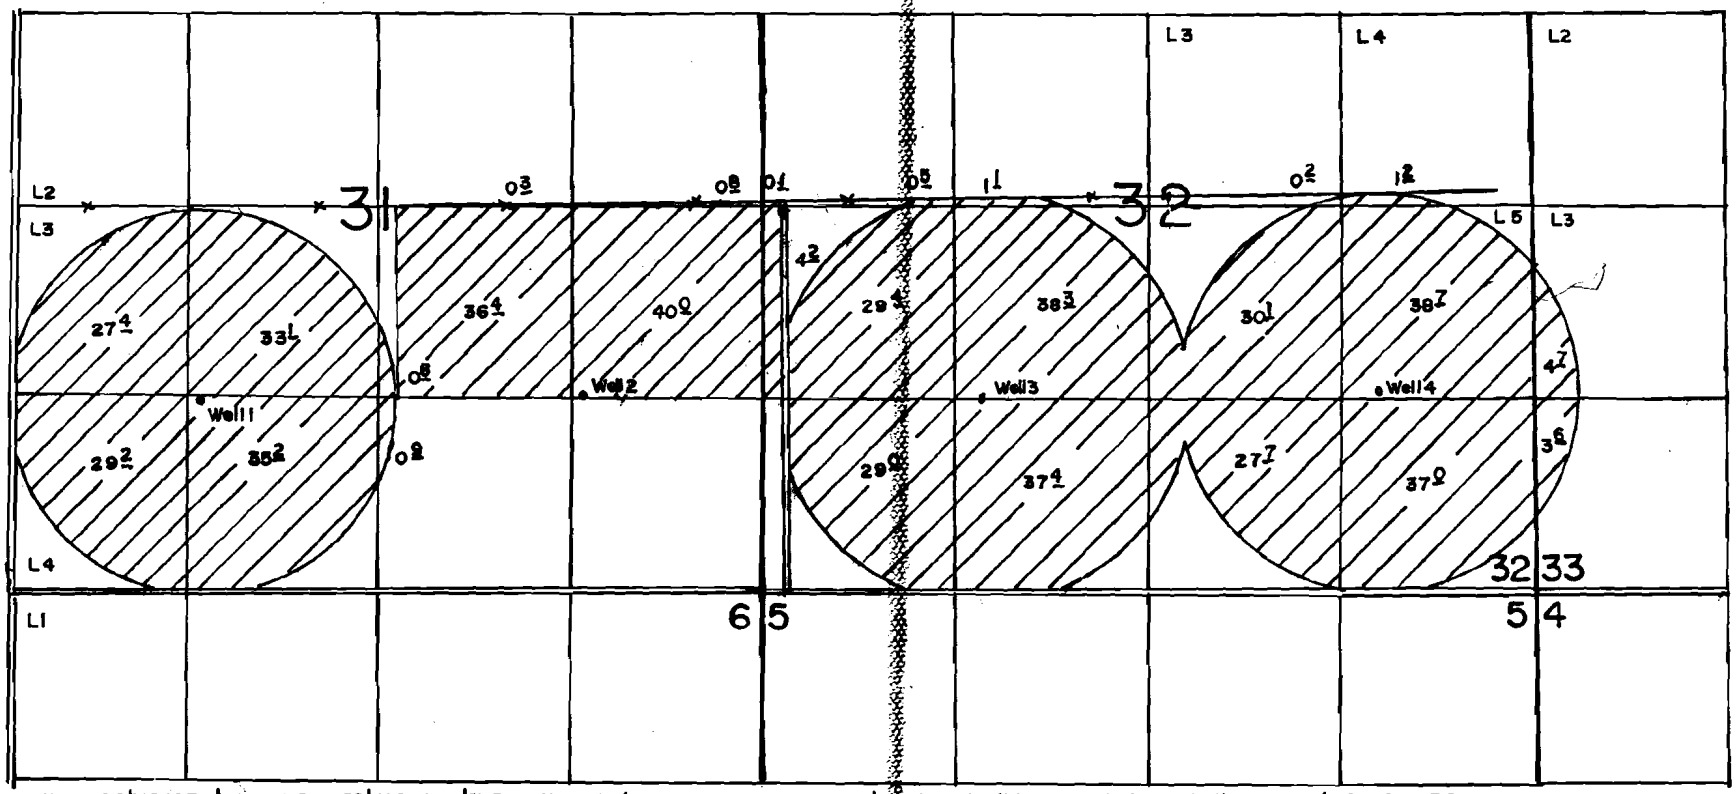

Well 1-1300'N&1230'W, Well 2-1350' N&1400'E, Both From S1/4 Cor. Sec 31 Well 3-1340'N&1500W, Well 4-1360N&1580E, Both From S1/4 Cor Sec 32

FINAL PROOF SURVEY

UNDER

Application No G-10071 Permit No G-9124

IN NAME OF

TERRY L NOFZIGER

Surveyed June 14 1990 By B.W. BISHOP

PTS 11-1990 9-5-90 DLM