
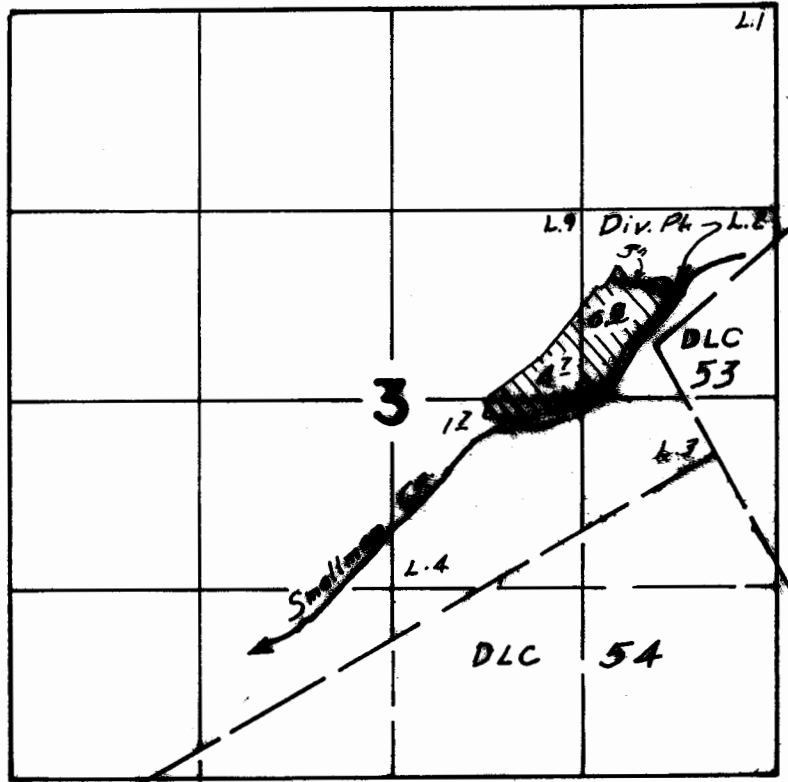


T.10S. R.2W.W.M.

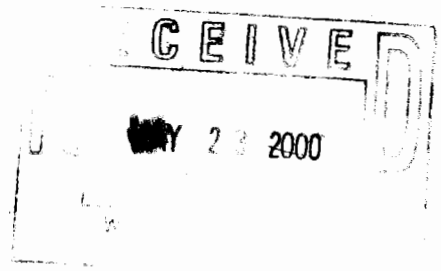

Div. Pt. loc. 430' N & 180' E from W'ly NW Cor. DLC 53

FINAL PROOF SURVEY
UNDER

Transfer No. T-7375
Application No. Permit No.
IN NAME OF

MT. JEFFERSON FARMS

Surveyed April 24 2000 by



THIS MAP WAS PREPARED FOR THE PURPOSE OF IDENTIFYING THE LOCATION OF A WATER RIGHT ONLY AND IS NOT DESIGNED TO PROVIDE LEGAL ADVICE OR LOCATION OF PROPERTY BOUNDARY LINES.

REC-517 18-07