


T. 20 S., R. 3 W., W.M.

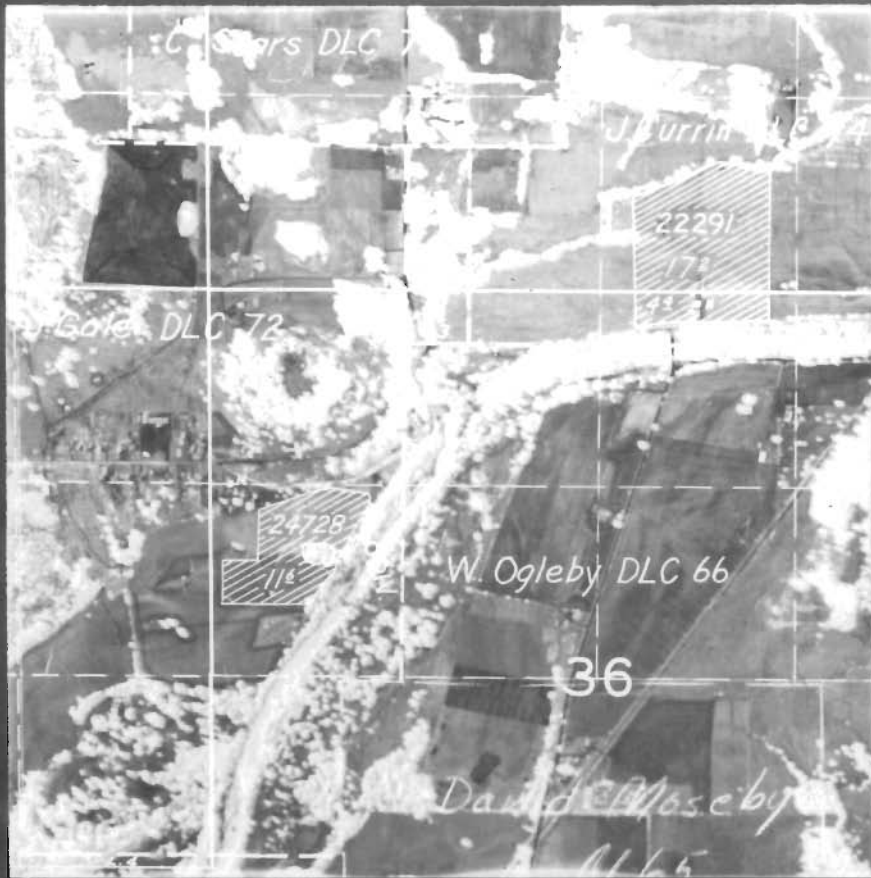

FINAL PROOF SURVEY

UNDER

22291 17577

Application No. 24728 Permit No. 19500

IN NAME OF
R. M. Seaver

Henry F. Russum

Surveyed May 4, 1954, by T. Jones

DBQ-5H-125