

FINAL PROOF MAP


T.4S., R.3W., SECTIONS 19 & 30

RECORDED
APR 2 1997
WATER RESOURCES DIVISION
SALEM, OREGON

APPLICATION NO. G-13595

PERMIT NO. G-11806

IN THE NAME OF: **WILLIAM BRANIN**
2937 NE 59TH AVE.
PORTLAND, OR 97213

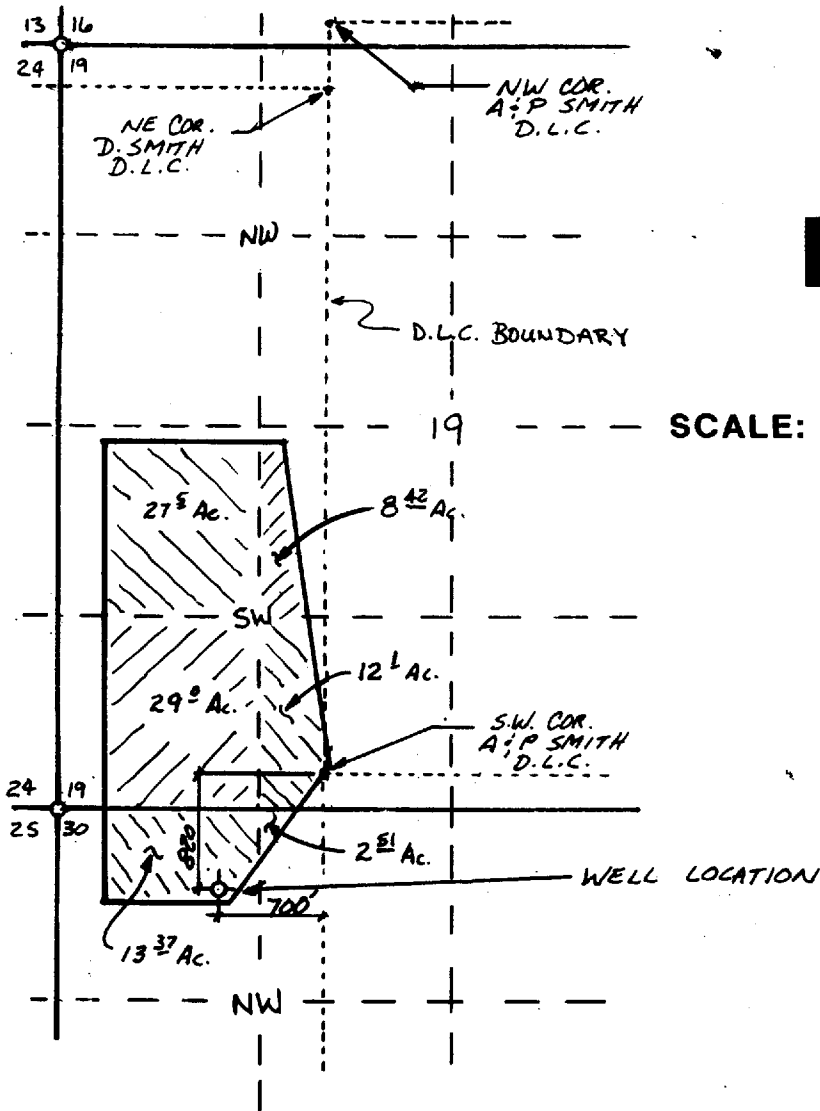

NOTE: Map is for the purpose of identifying location of water right and has no intent to dimension or locate property ownership lines.