


T. 18S, R. 12W., W.M. SECTION 11
POINT OF DIVERSION FOR PERMIT NO. S37524

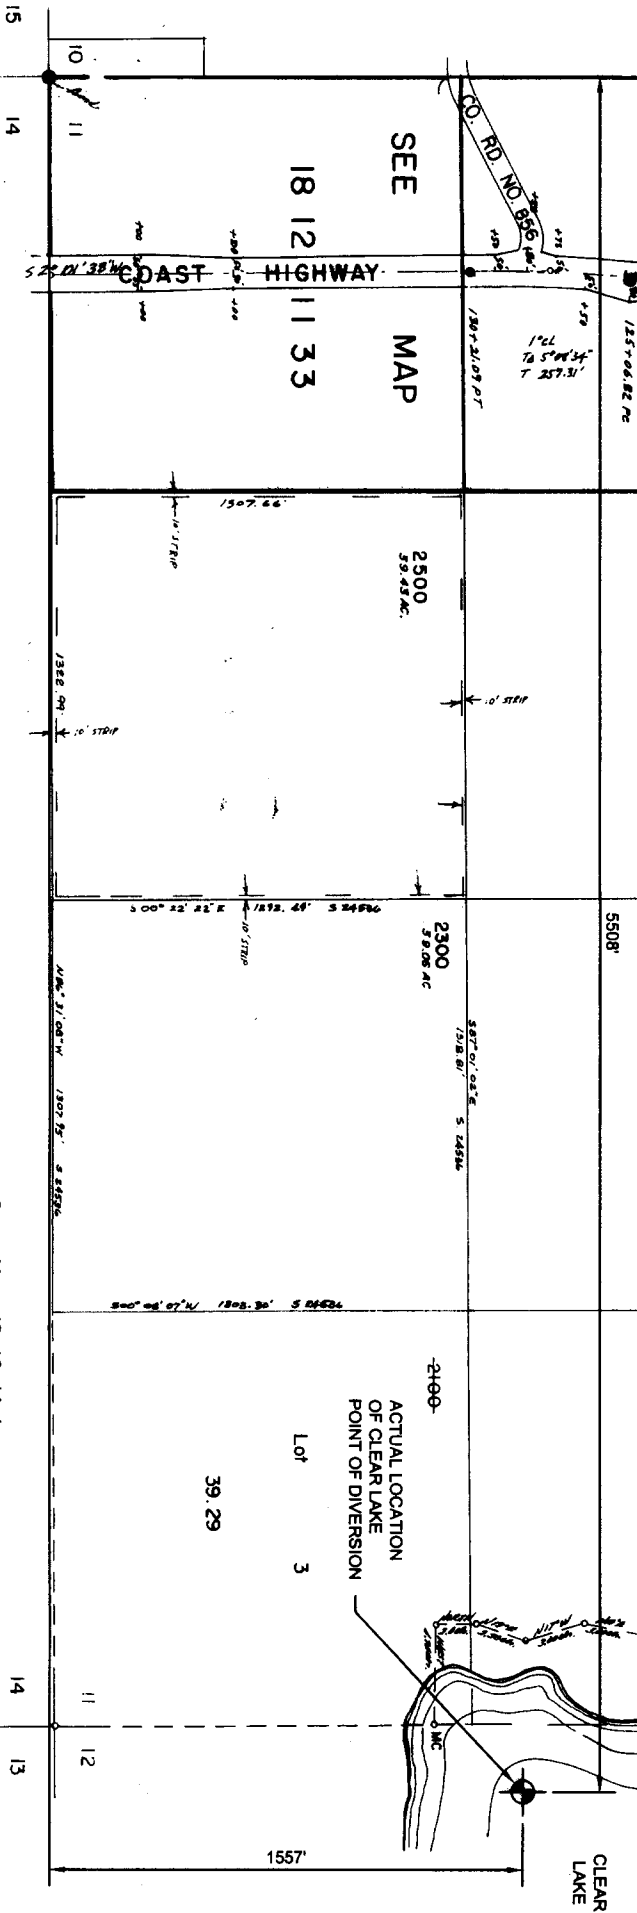

See Map 18 12 14

See Map 18 12 14 1

COBU MAP #

NOTE:
This map is for the purpose of identifying the location of the water right only
and is not intended to provide legal dimensions or locations of property lines.

FINAL PROOF SURVEY FOR PERFECTION OF
APPLICATION NO. 52076, PERMIT NO. S37524

IN THE NAME OF
HECETA WATER DISTRICT
LANE COUNTY
JULY 2003




Mark P. C. 175
May 14, 2003
Exp. 12/29/03

WEST
Y O B
A ASSOCIATES

CORU MAP #

T. 17S. R. 12W. W.M.
LANE COUNTY
7-2000

17 12
INDEX

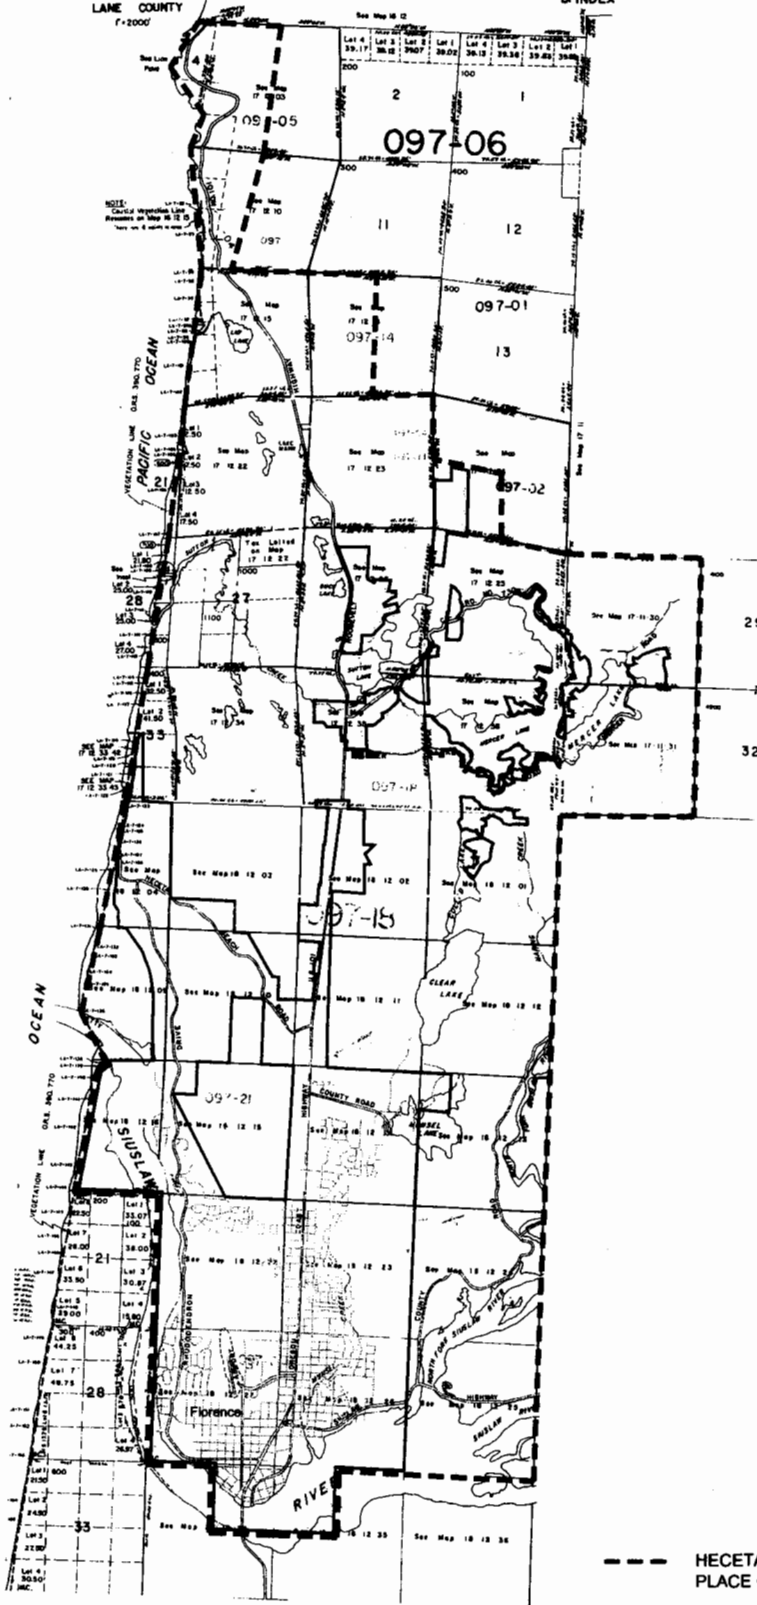

--- HECETA WATER DISTRICT
PLACE OF USE BOUNDARY
— HECETA WATER DISTRICT
CURRENT USE BOUNDARY

PLACE OF USE MAP FOR PERFECTION OF
APPLICATION NO. 52076, PERMIT NO. S37524

IN THE NAME OF
HECETA WATER DISTRICT
LANE COUNTY
AUGUST 2003

WEST
YOST
& ASSOCIATES

