


T. 33S. R. 6E.

27

July 16 to Aug 3, 1927.

34

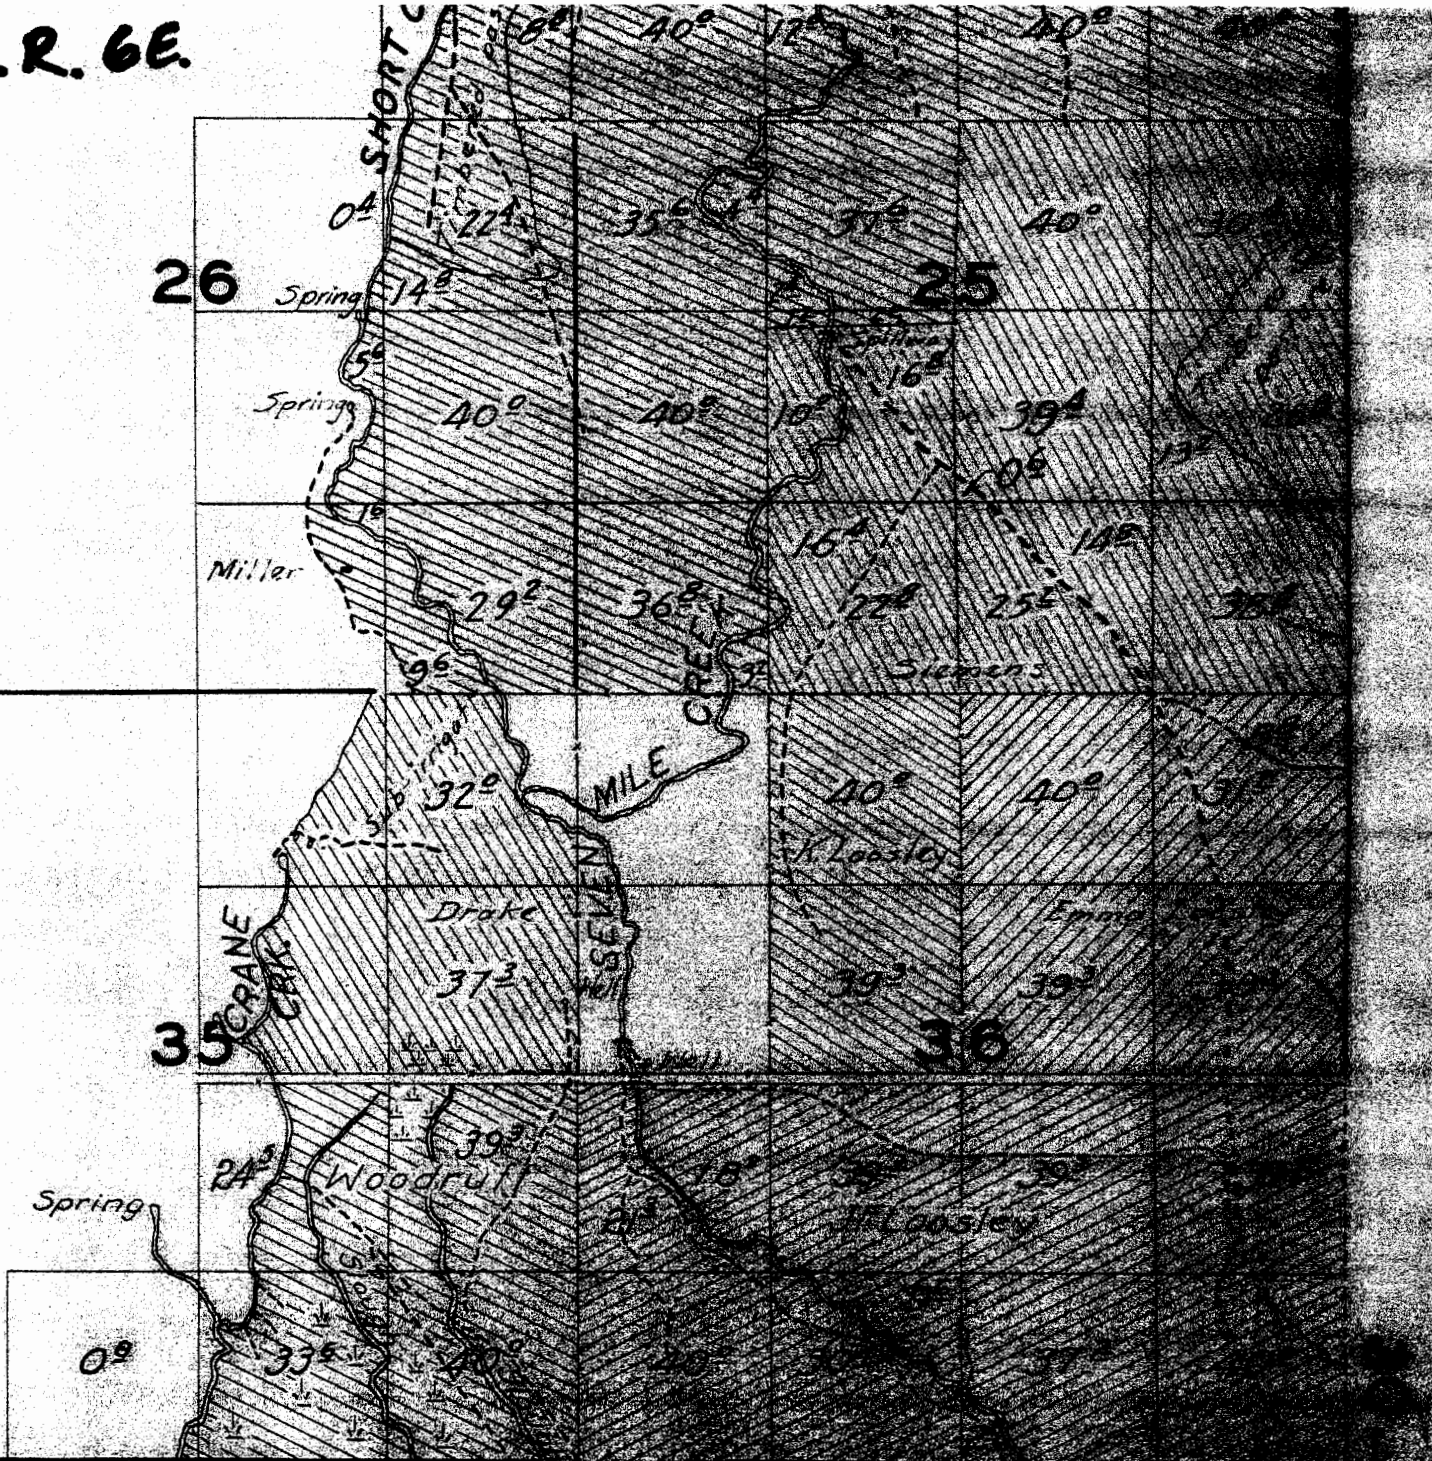

T.34S. R.6E.

