

P-114 807

FROM OFFICE OF THE STATE

Ap 2203 Per 11-4

14

23

23

33

15

22

27

34

16

21

28

33

17

20

29

32

18

19

30


31

T. 9 S. R. 2 E

Birch spring
 No Name spring No.
 No Name spring No.
 Cottonwood Spring No.
 Cottonwood Spring No.
 Saryio spring

1320
 Pipe 1118
 (5600)

Survey By H. K. Donnelly

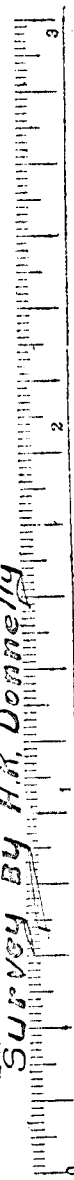

Scale of Feet.