
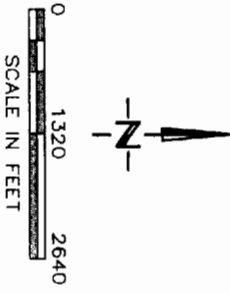


**BUTTER CREEK IRRIGATION DISTRICT
FINAL PROOF SURVEY**

T. 2 N., R. 27 E. WM.

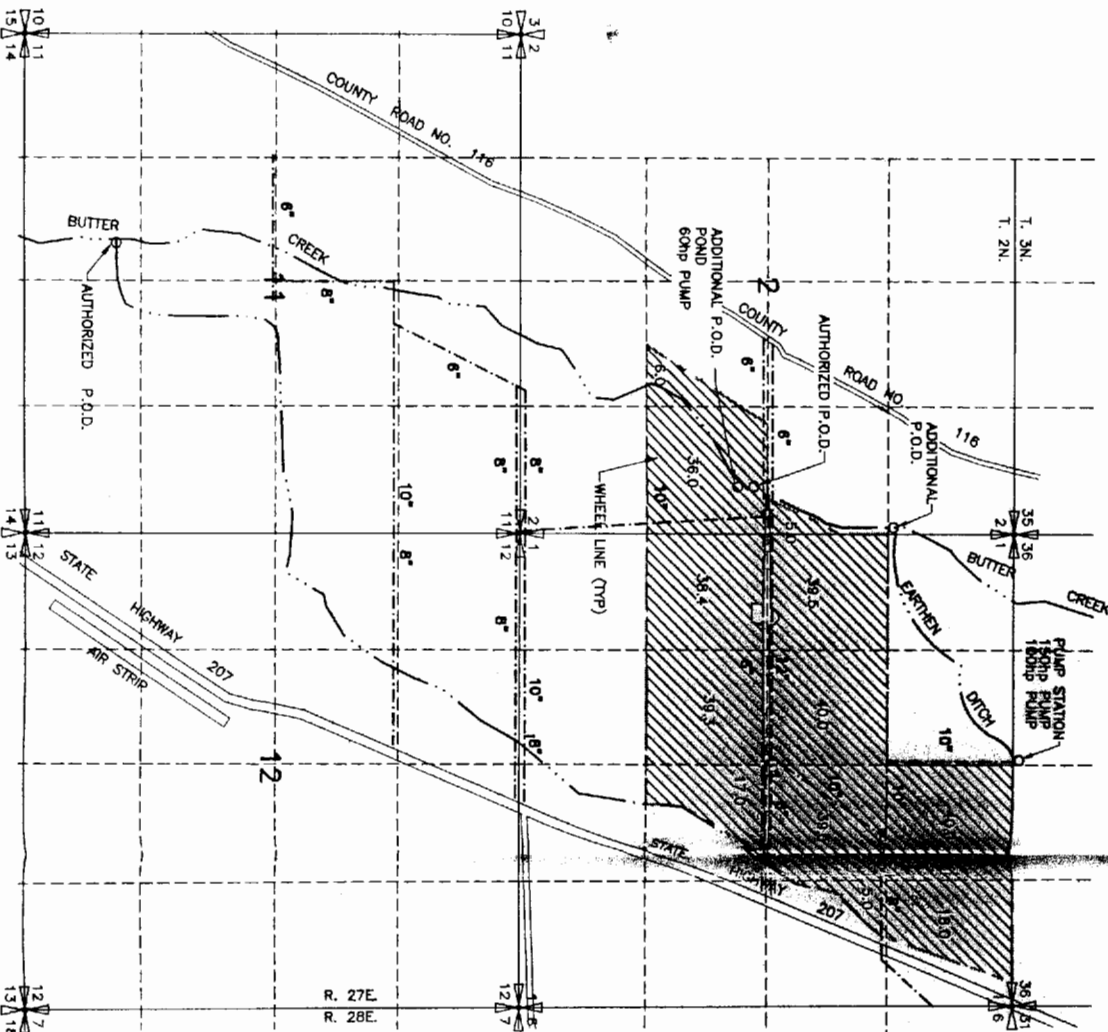

RECEIVED

NOV 09 1998

--- 6" --- DISTRIBUTION SYSTEM
 [Hatched Box] AREA OF BENEFICIAL USE
 [Dashed Line] IRRIGATED WITH WHEEL LINES AND HAND LINES
 WATER RESOURCES DEPT
 SALEM, OREGON

NOTE: THE PURPOSE OF THIS MAP IS TO IDENTIFY THE APPROXIMATE LOCATION OF THE WATER RIGHT. IT IS NOT INTENDED TO PROVIDE INFORMATION RELATIVE TO THE LOCATION OF PROPERTY OWNERSHIP BOUNDARY LINES.



BGM Consultants, Inc. Architects & Engineers
 3522.031
 SEPTEMBER 30, 1998
 3522BTP-DMS