


T.1S.R.2W.W.M.

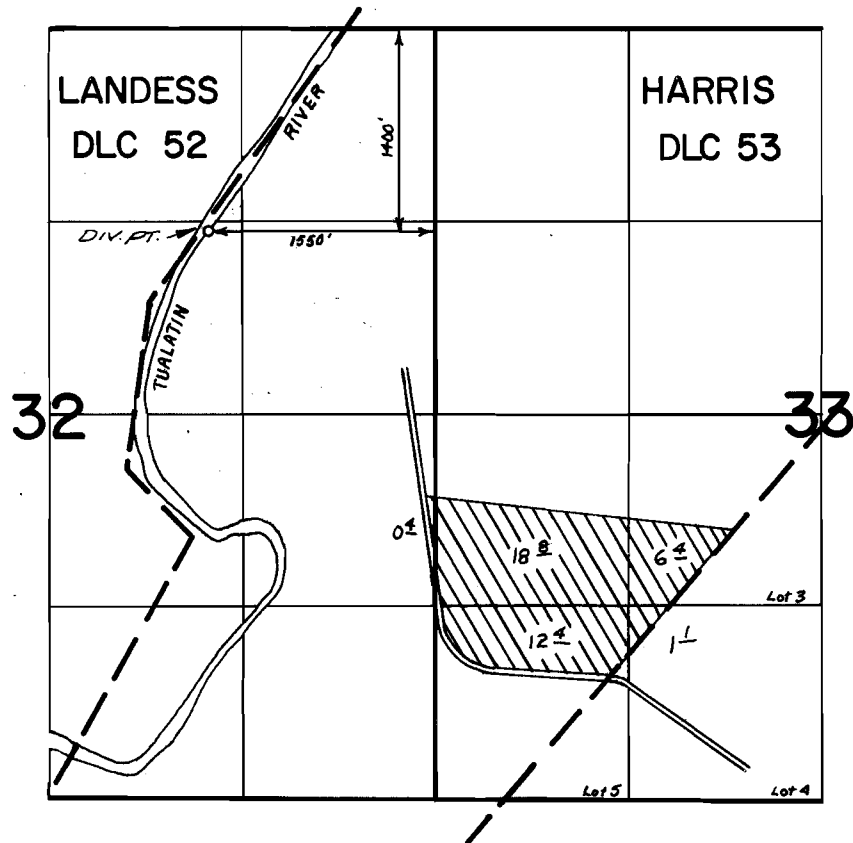

FINAL PROOF SURVEY UNDER

Application No. 48449 Permit No. 36368
IN NAME OF

ALVIN NEAL LUTTRELL

Surveyed MAY 16 1973, by R.G. MUCKEN